


# T.20S.R.3W.W.M.

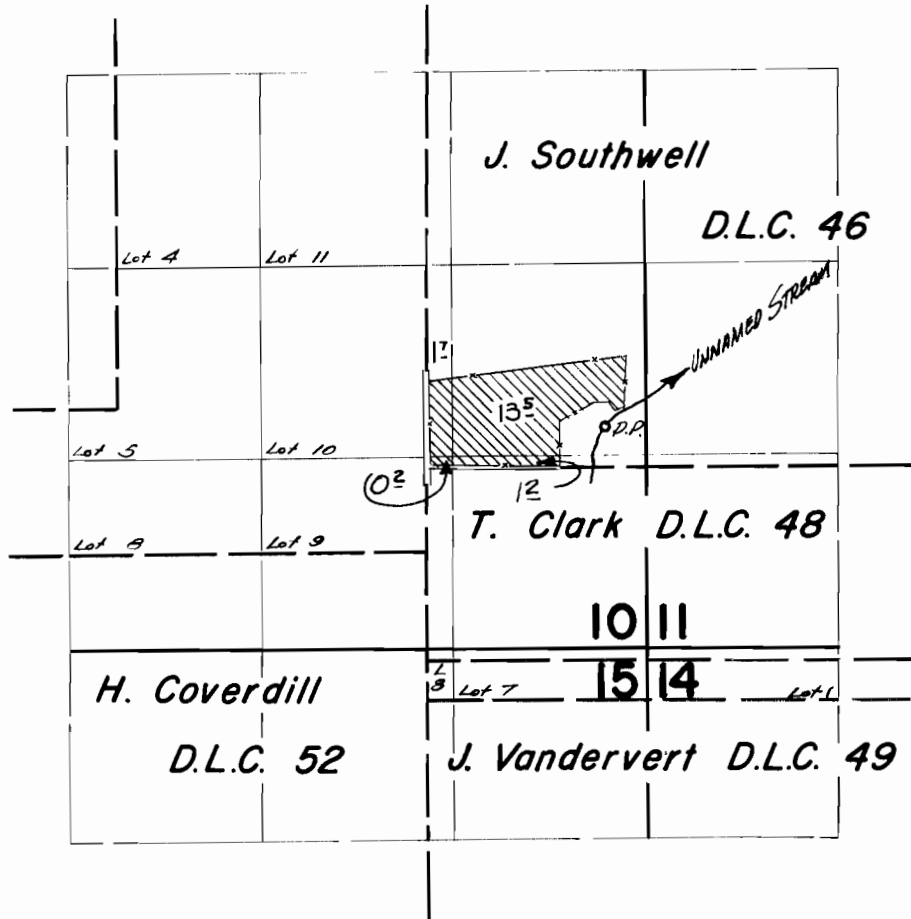

## FINAL PROOF SURVEY UNDER

Application No. 34550 Permit No. 27129  
IN NAME OF

JAMES EASLEY

Surveyed May 7, 1963, by C. Baker