


T.15S.R.1W.W.M.

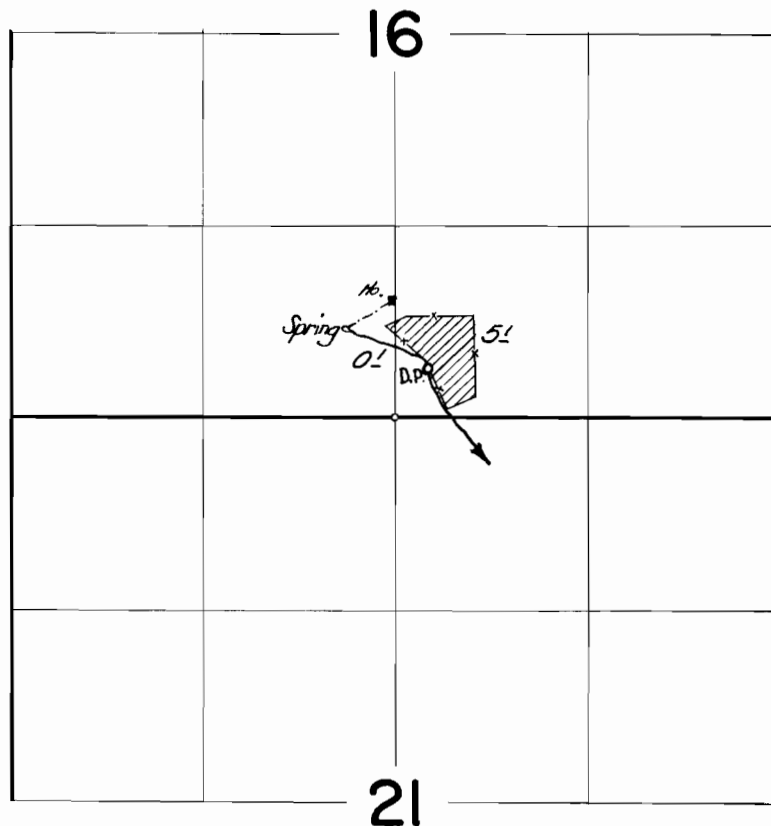

FINAL PROOF SURVEY
UNDER

Application No. 35047 Permit No. 27634
IN NAME OF

BILLY J. GLOVER

Surveyed May 8, 1964, by C. Baker