


T.20S.R.5W.W.M.

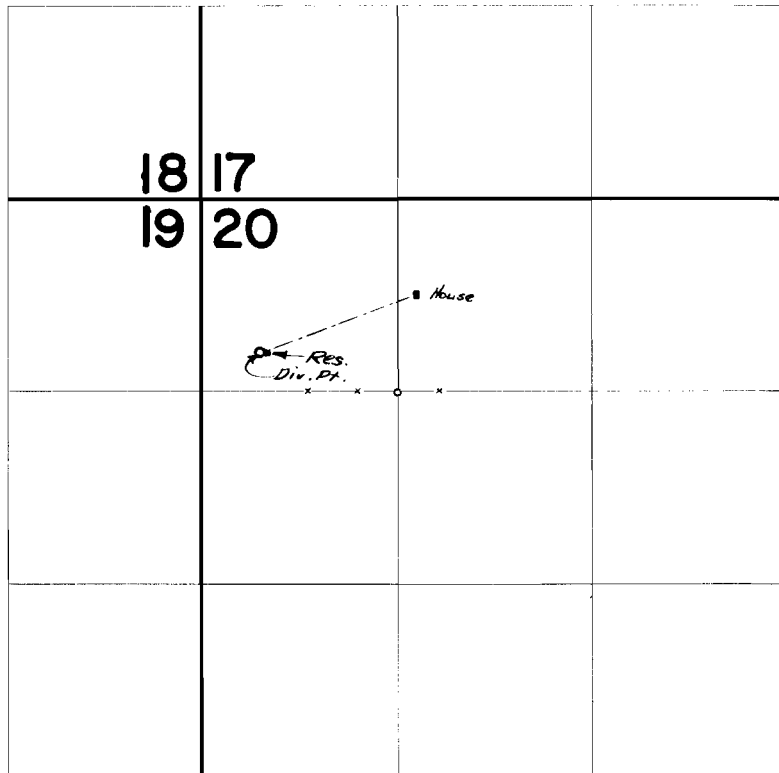

FINAL PROOF SURVEY UNDER

Application No. **38166** Permit No. **28415**
IN NAME OF

D. D. or RUBY L. SIMPSON

Surveyed May 7 1963, by **C. Baker**