


T.16&17S.R.3E.W.M.

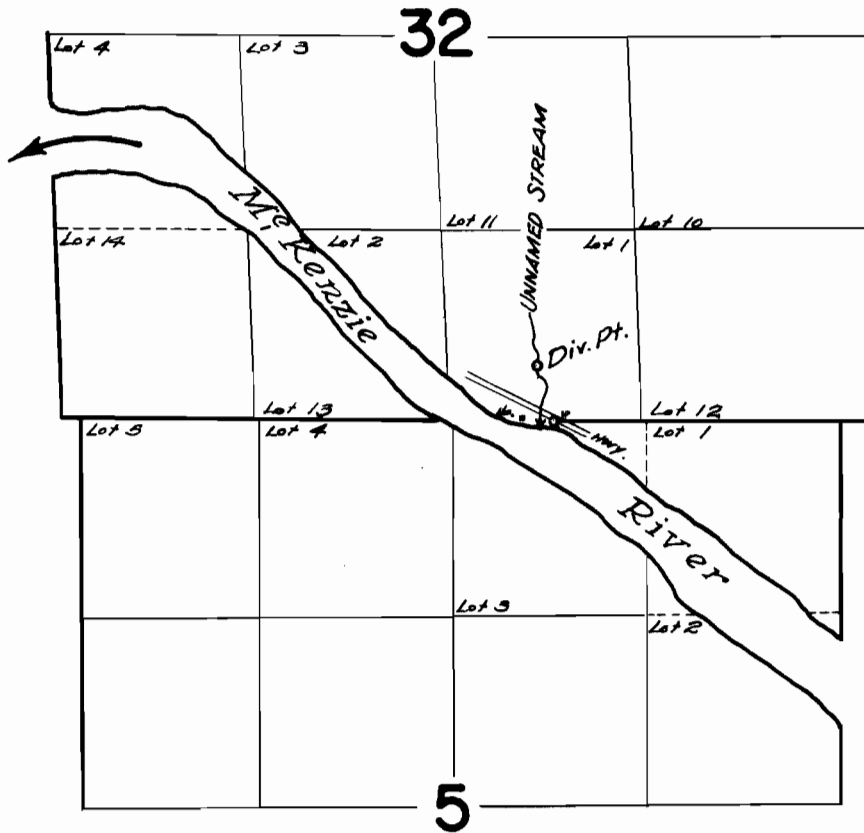

FINAL PROOF SURVEY
UNDER

Application No. 38260 Permit No. 28510
IN NAME OF

GEORGE E. & FRANCES FORCIA

Surveyed June 17, 1963, by C. Baker