


T.10S.R.10W.W.M.

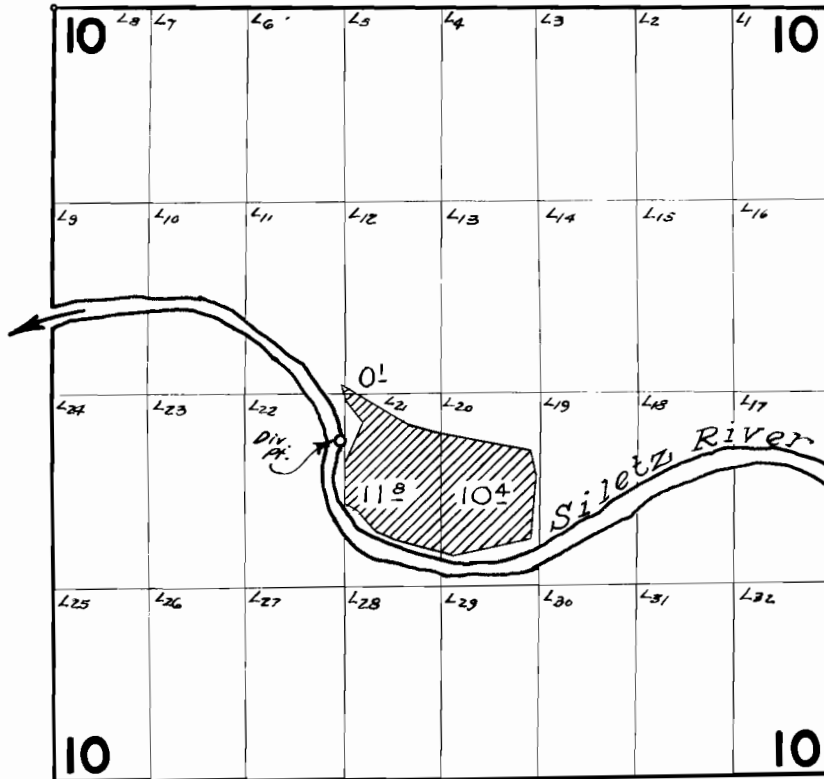

FINAL PROOF SURVEY UNDER

Application No. **31630** ... Permit No. **24932** ...
IN NAME OF

ERICH D. BAHRKE

Surveyed June 27 1963, by C. Baker. ...