


T.10S.R.10W.W.M.

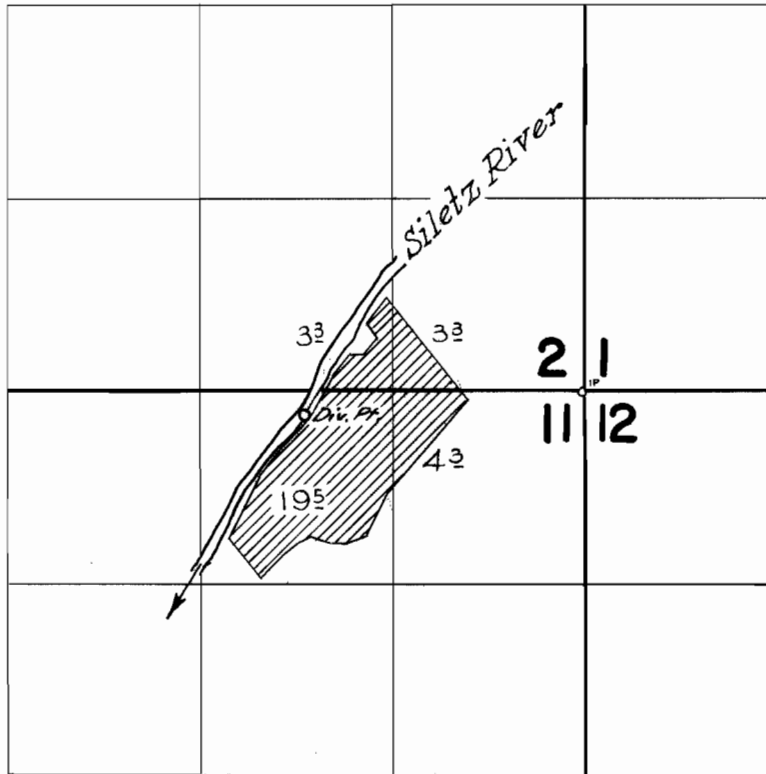

FINAL PROOF SURVEY UNDER

Application No. 33985 Permit No. 26781
IN NAME OF

MELVIN A. TEAGUE

Surveyed June 26 1963, by C. Baker