


T.10S.R.7&8W.W.M.

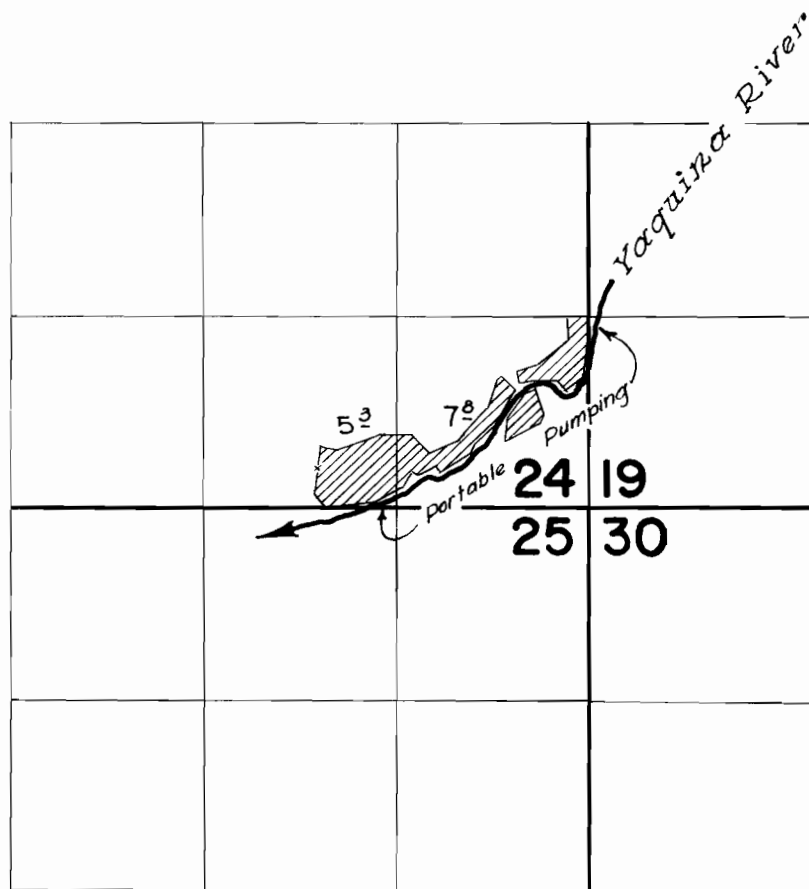

FINAL PROOF SURVEY
UNDER

Application No. 34512 Permit No. 27107
IN NAME OF

ALVIN HAMAR

Surveyed June 25 1963, by C. Baker