


T.12S. R.3W. W.M.

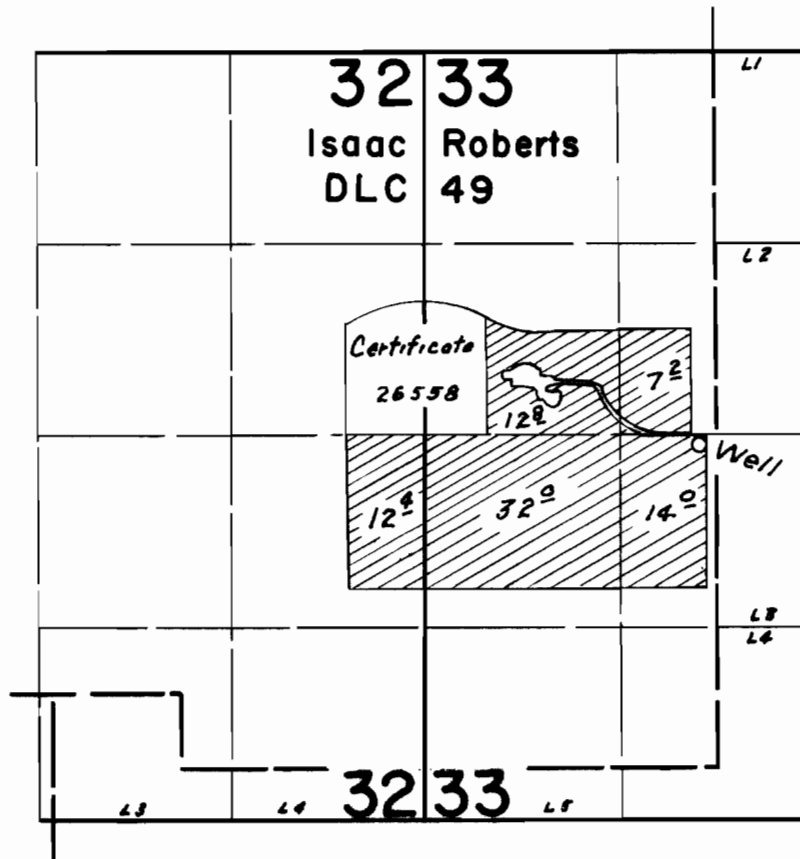

FINAL PROOF SURVEY
UNDER

Application No. G-994 Permit No. G-876...
IN NAME OF

LEONARD & BETTY JEAN FORSTER

Surveyed Oct. 16, 1964, by C.J. Gardner...