


T.10S.R.2W.W.M.

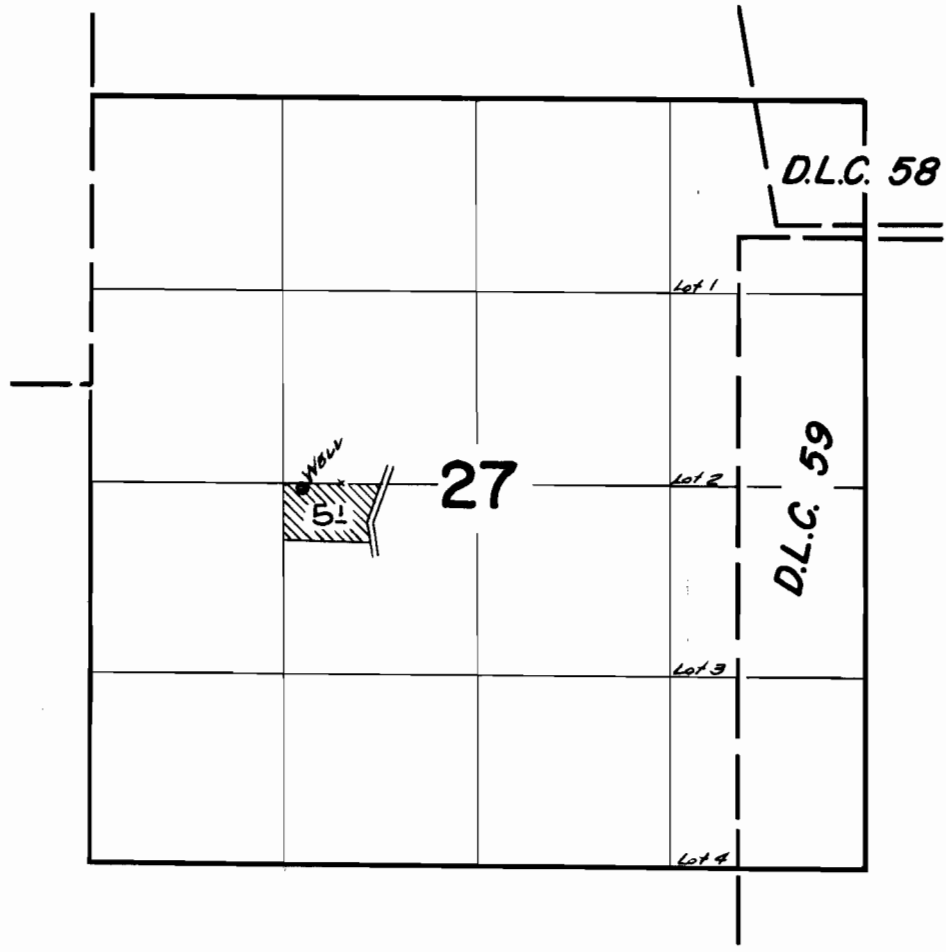

FINAL PROOF SURVEY UNDER

Application No. G-1256. Permit No. G-1082.
IN NAME OF

DONALD G. DAVIS

Surveyed *Sept. 4, 1963*, by *C. Baker*