


T.12S.R.4W.W.M.

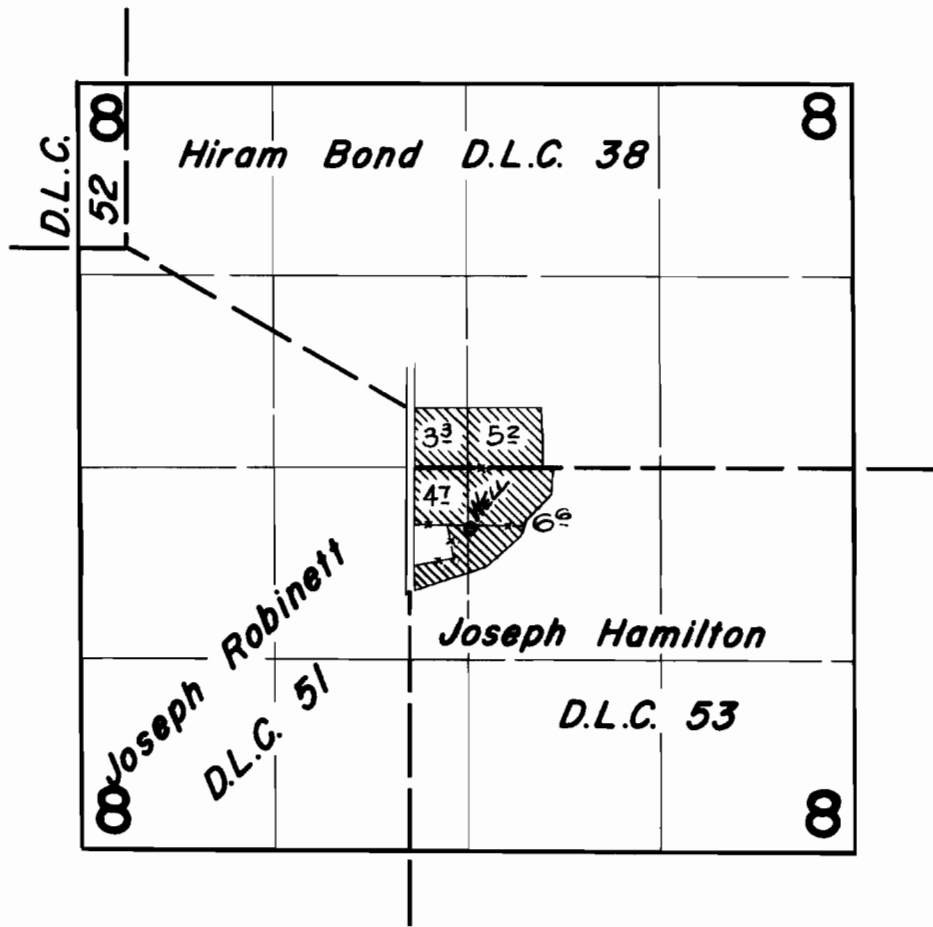

FINAL PROOF SURVEY UNDER

Application No. G-1715... Permit No. G-1573...
IN NAME OF

R. G. GATES

Surveyed July 1, 1963, by C. Baker