


T.10S.R.3W.W.M.

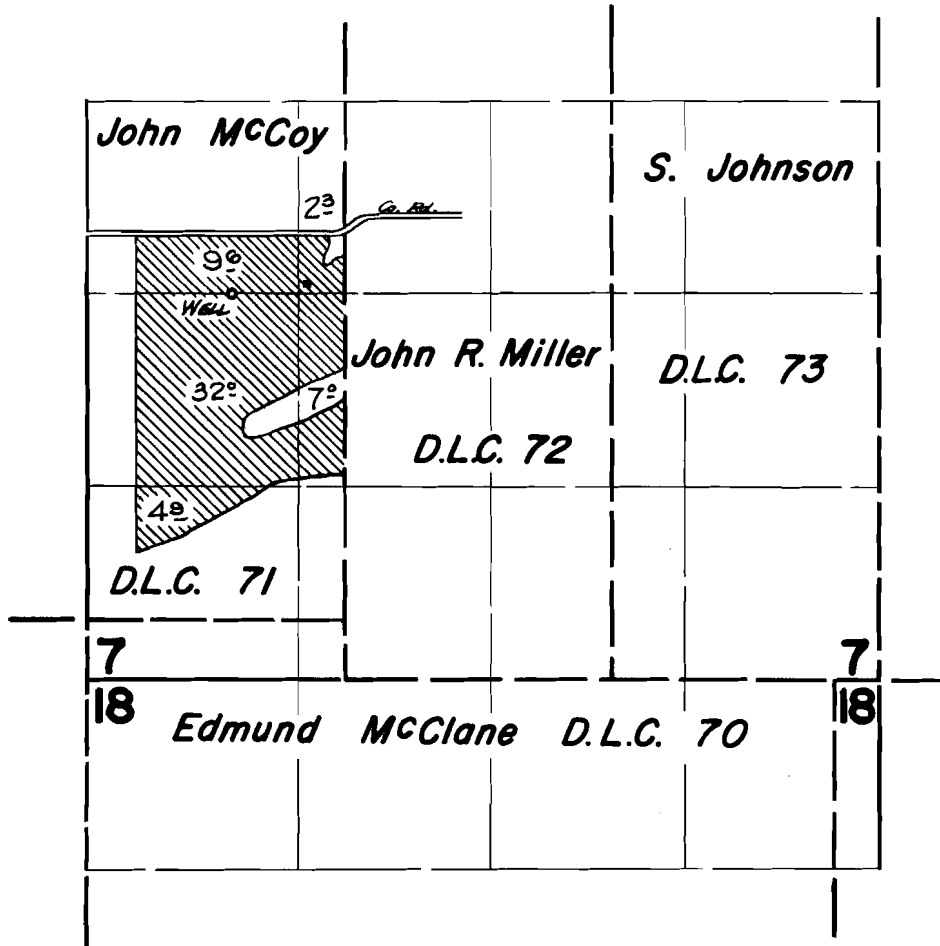

FINAL PROOF SURVEY
UNDER

Application No. **G-1951** Permit No. **G-1793**
IN NAME OF

BERTHA L. BARNES

Surveyed May 1, 1964, by *R. Jackson*