


T.10S.R.3 W.W.M.

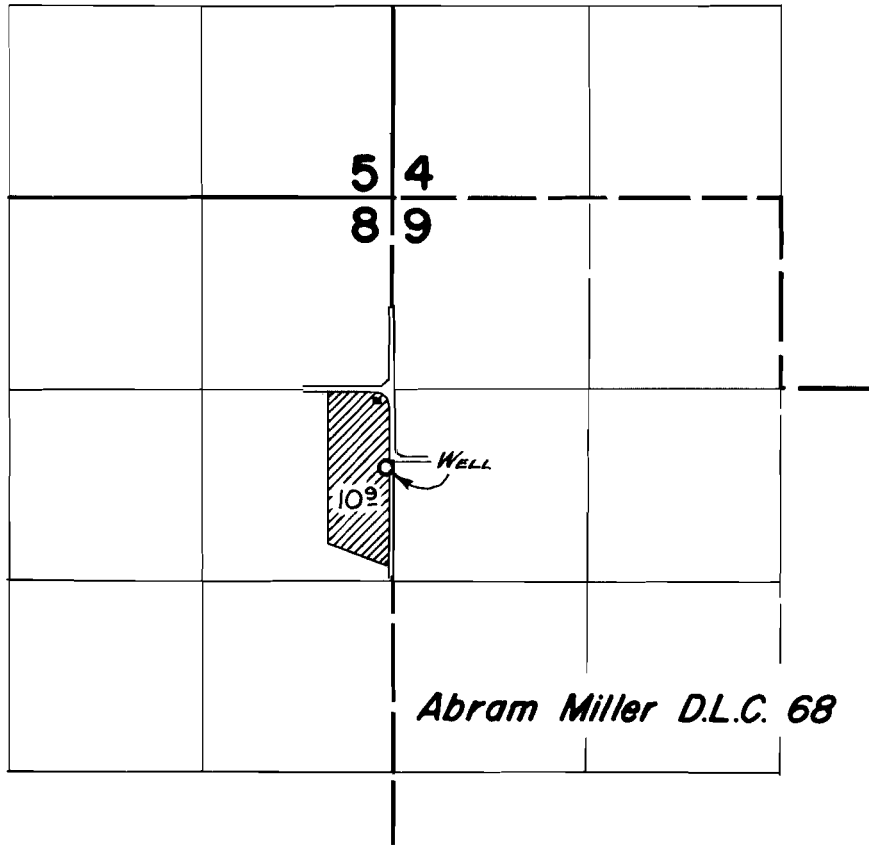

FINAL PROOF SURVEY UNDER

Application No. G-2006 Permit No. G-1844
IN NAME OF

M. C. CASE

Surveyed April 29 1964, by L. Jackson