


T.12S.R.4 W.W.M.

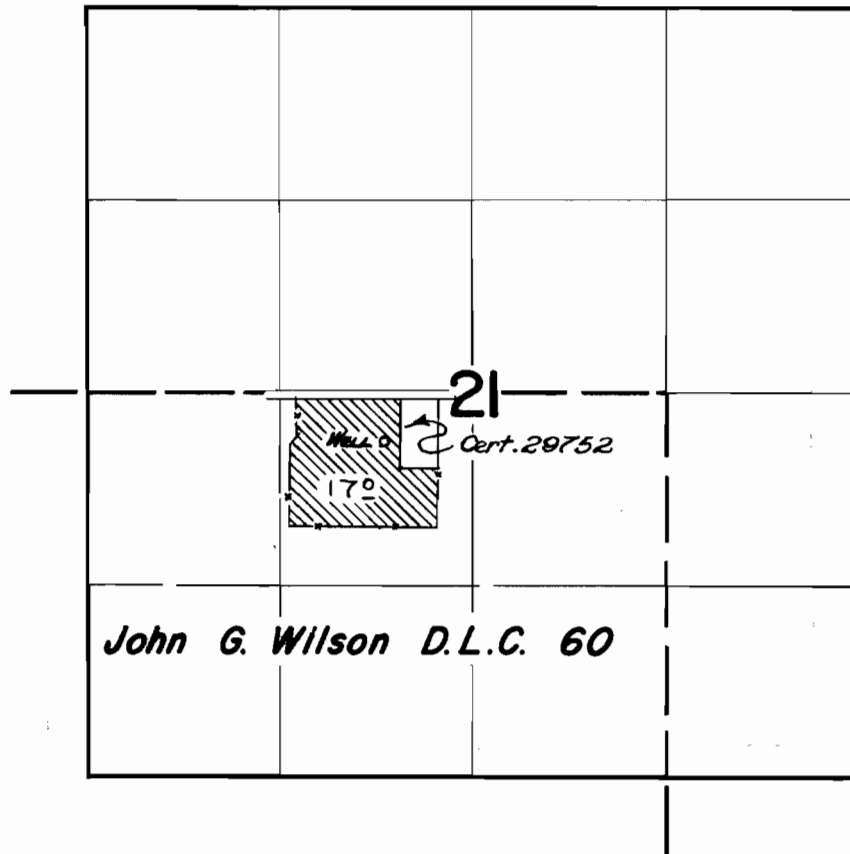

FINAL PROOF SURVEY UNDER

Application No. G-2200, Permit No. G-2024
IN NAME OF

.....ROBERT C. MANG.....

Surveyed July 1, 1963, by C. Baker.....