


T.10S.R.3W.W.M.

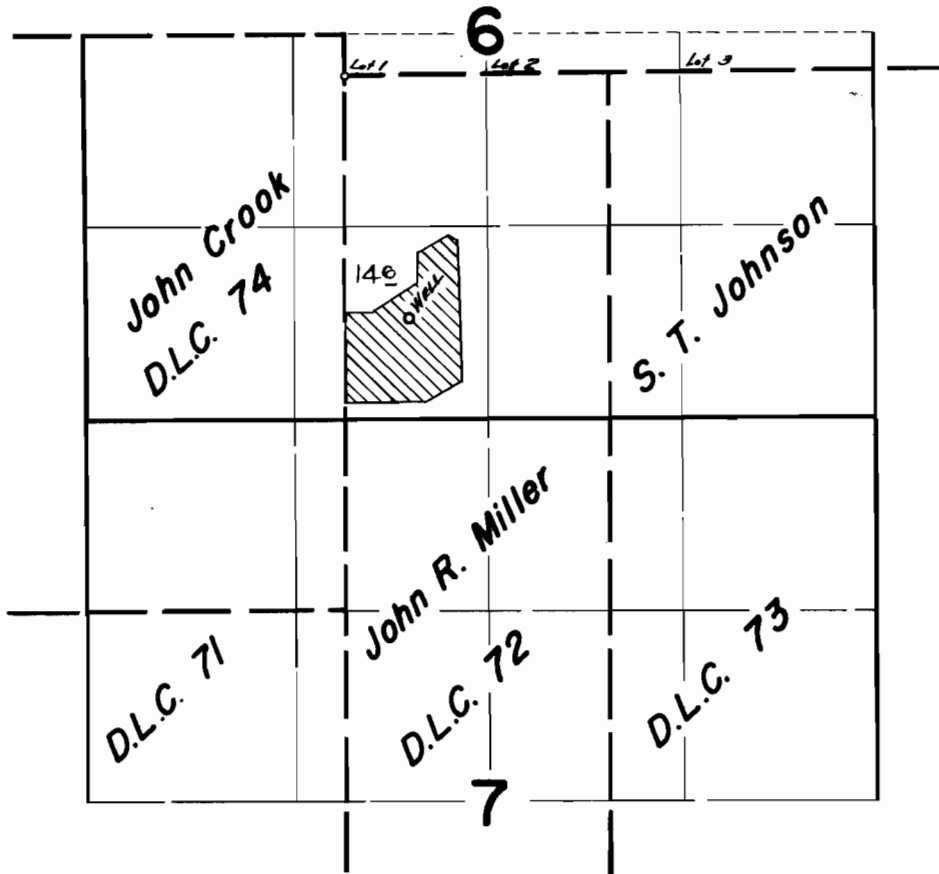

FINAL PROOF SURVEY UNDER

Application No. G-2279. Permit No. G-2088.
IN NAME OF

D.L. & EVA A. COOK

Surveyed Sept. 6, 1963, by C. Baker.....

RA