


T.14S.R.1W.W.M.

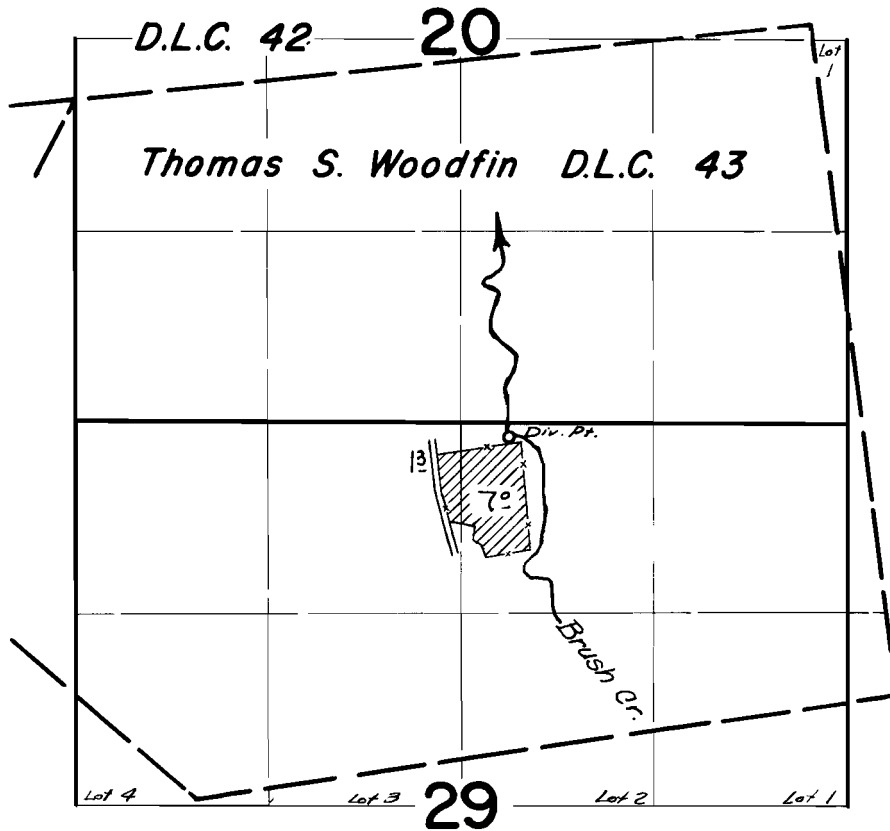

FINAL PROOF SURVEY
UNDER

Application No. **30826** Permit No. **24265**
IN NAME OF

CARL A. & MARGUERITE ARVIDSON

Surveyed July 3 1963, by C. Baker