


T.13S.R.18&2E. W.M.

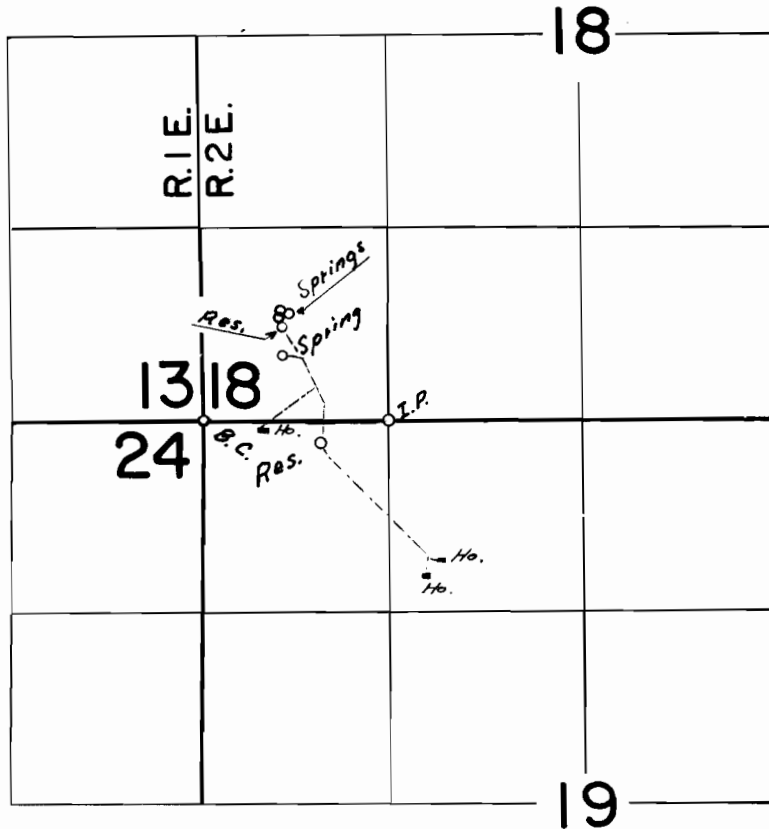

FINAL PROOF SURVEY
UNDER

Application No. 31644 Permit No. 25023

IN NAME OF

TOM HELFRICH and HERBERT HUGHES

Surveyed Nov. 5, 6, 1964, by C. J. Gardner