


T.12S.R.4W.W.M.

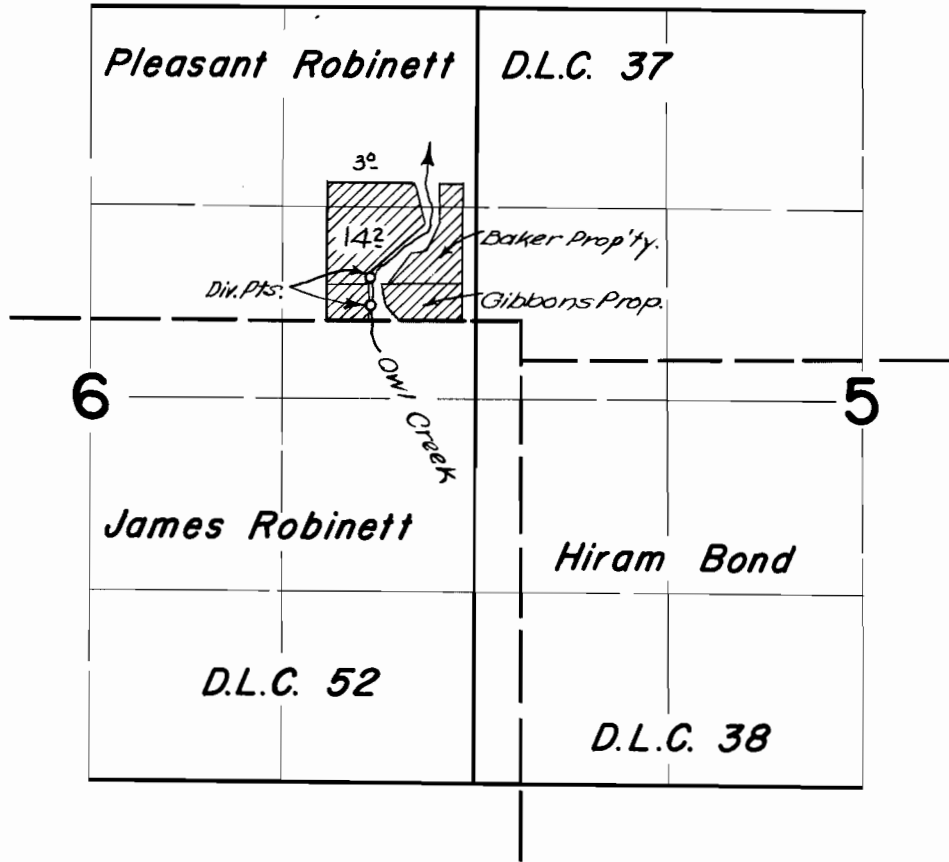

FINAL PROOF SURVEY
UNDER

Application No. 32353... Permit No. 25549...
IN NAME OF

MARTIN H. BAKER, JR.

Surveyed July 1, 1963, by C. Baker