


T.I.O.S.R. | W.W.M.

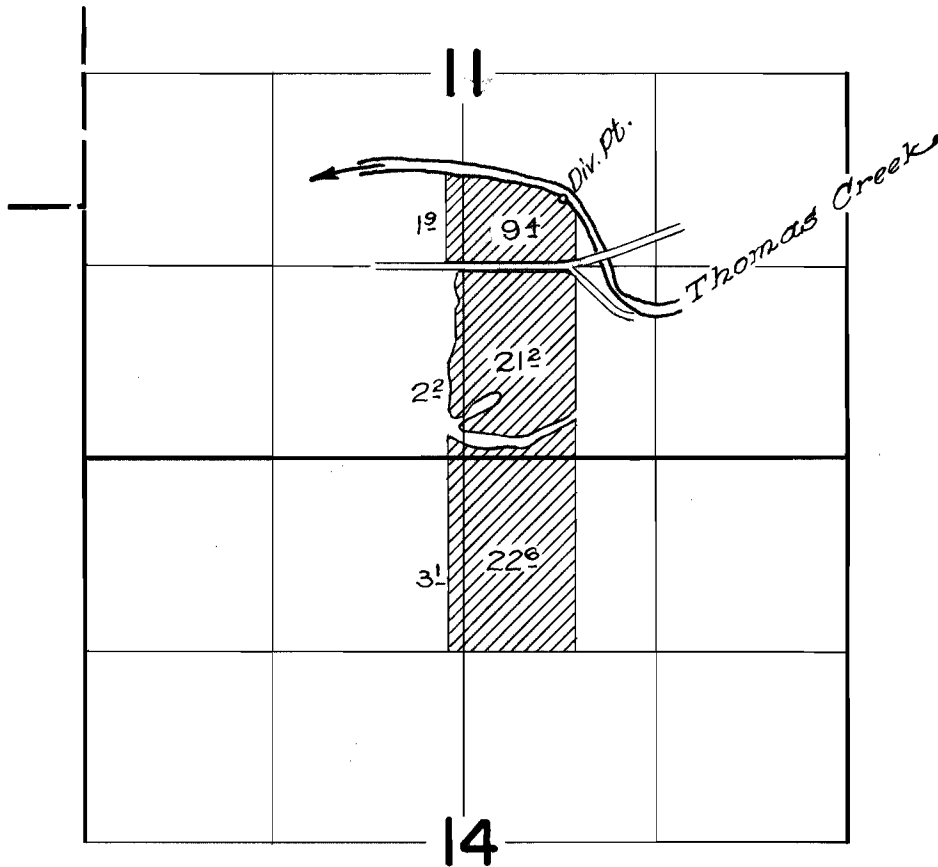

FINAL PROOF SURVEY UNDER

Application No. 33182... Permit No. 26245...
IN NAME OF

..... LEMOND MOORE

Surveyed Sept. 6 1963, by C. Baker.....