


T.14S.R.1W.W.M.

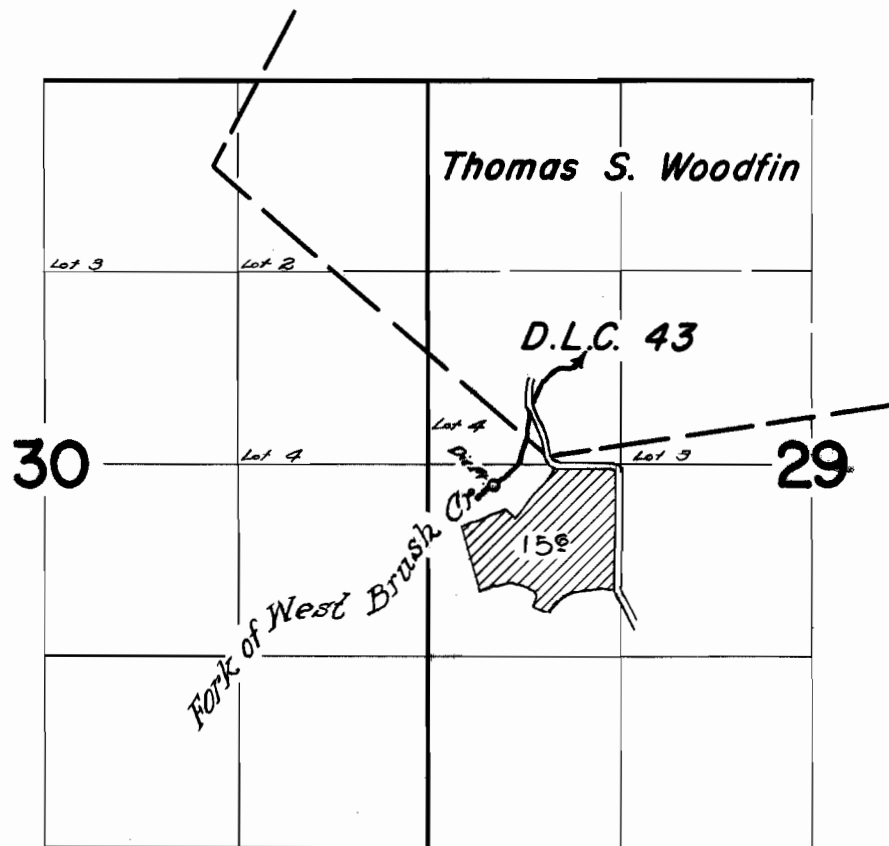

FINAL PROOF SURVEY
UNDER

Application No. 33687... Permit No. 26630...
IN NAME OF

THEODORE & SUE M^CELROY

Surveyed May 29 1963, by O. Baker.....