


T. 10 S. R. 1 & 2 W. W. M.

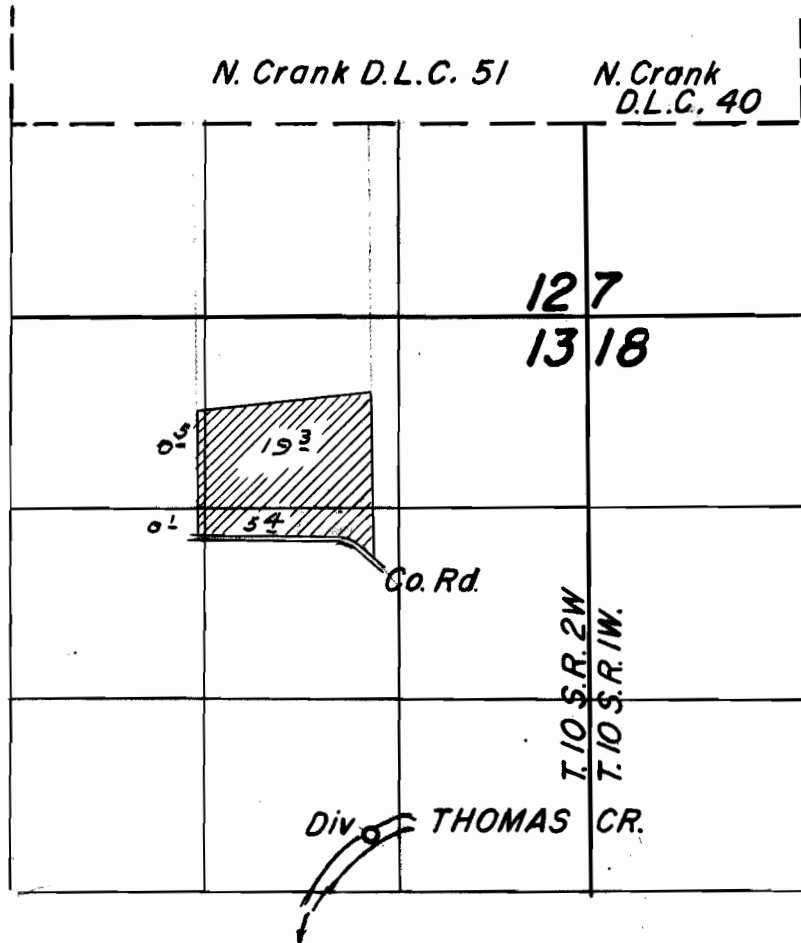

FINAL PROOF SURVEY
UNDER

Application No. 33740 Permit No. 26645
IN NAME OF

Henry Novak

Surveyed Oct. 29 1964, by F. Siegmund