


T.10S.R.38&4W.W.M.

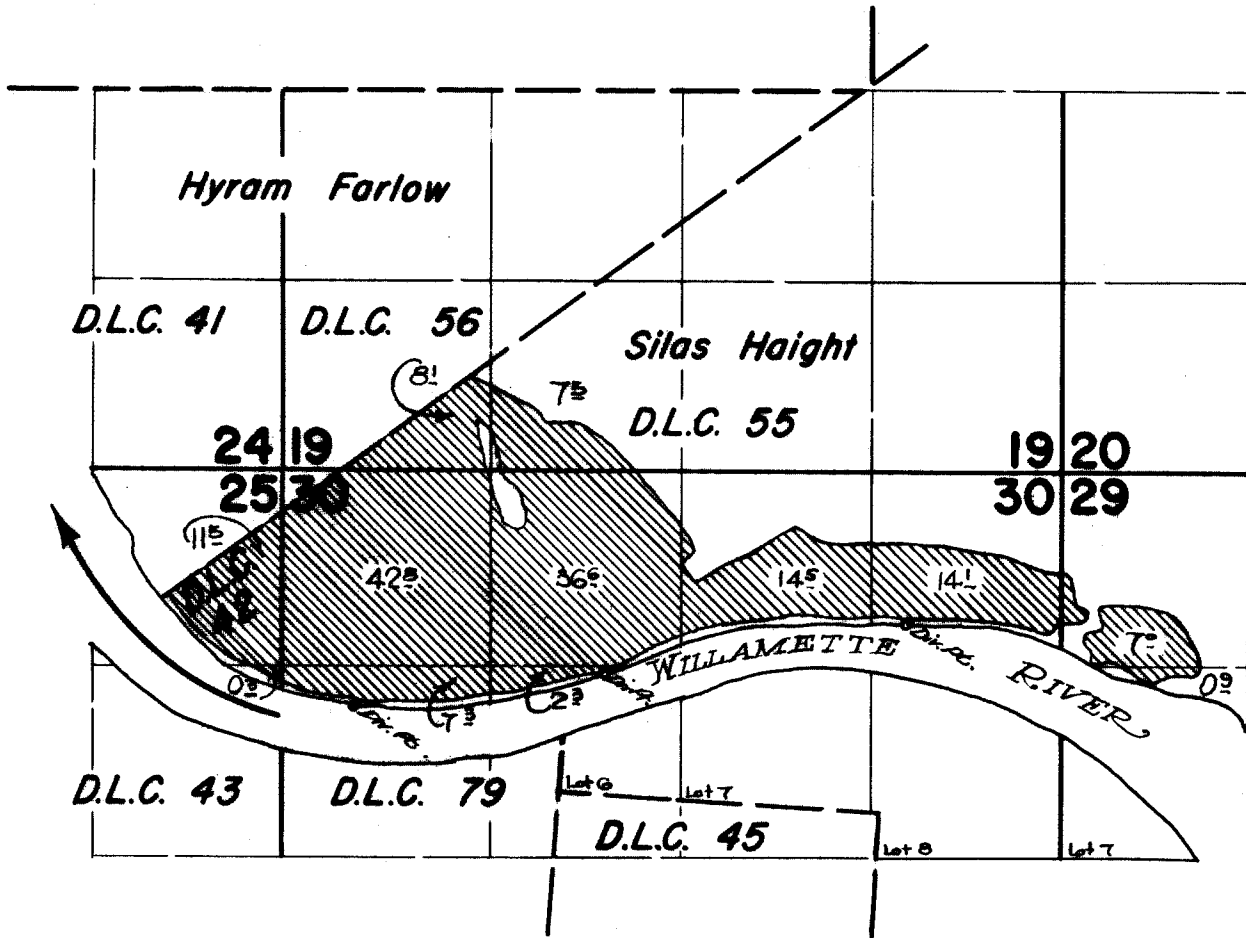

FINAL PROOF SURVEY UNDER

Application No. 34010... Permit No. 26828...
IN NAME OF

NOFZIGER AND GRAY

Surveyed November 6 1964., by *[Signature]*