


T.11S.R.2W.W.M.

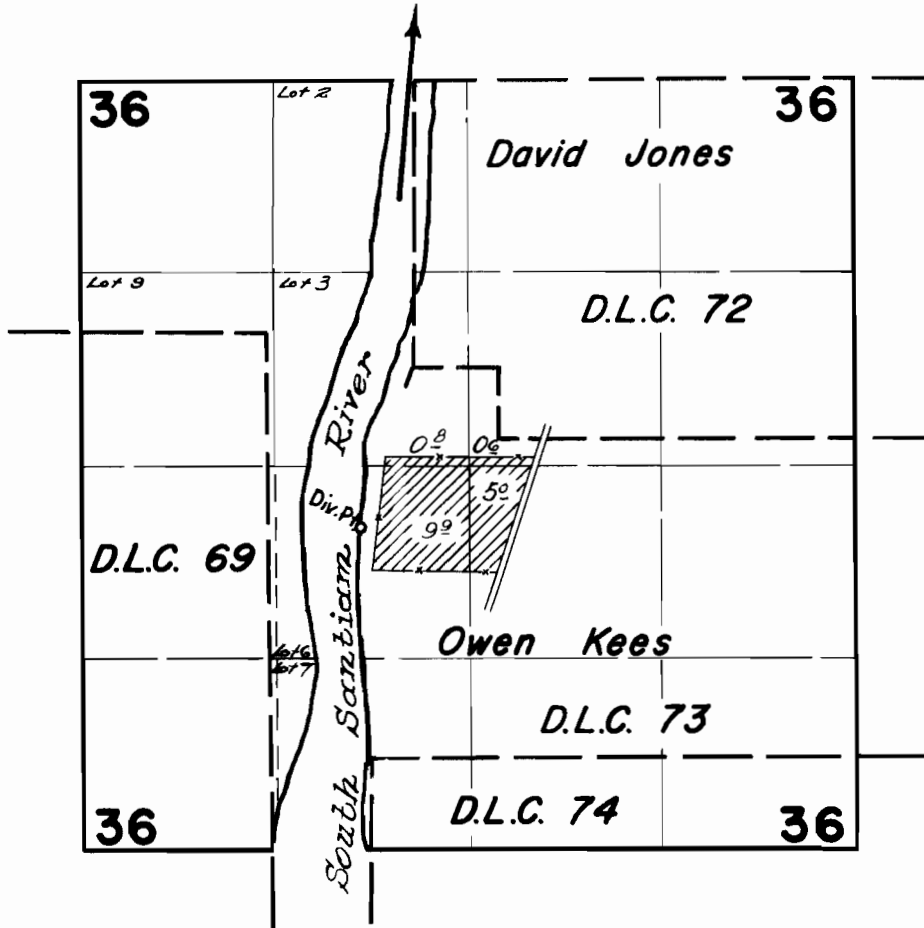

FINAL PROOF SURVEY
UNDER

Application No. **34805** Permit No. **27339**
IN NAME OF

WALTER & VERNA WHEELER

Surveyed *Sept. 5 1963* by *C. Baker*

1963-Y