


T.10S.R.4W.W.M.

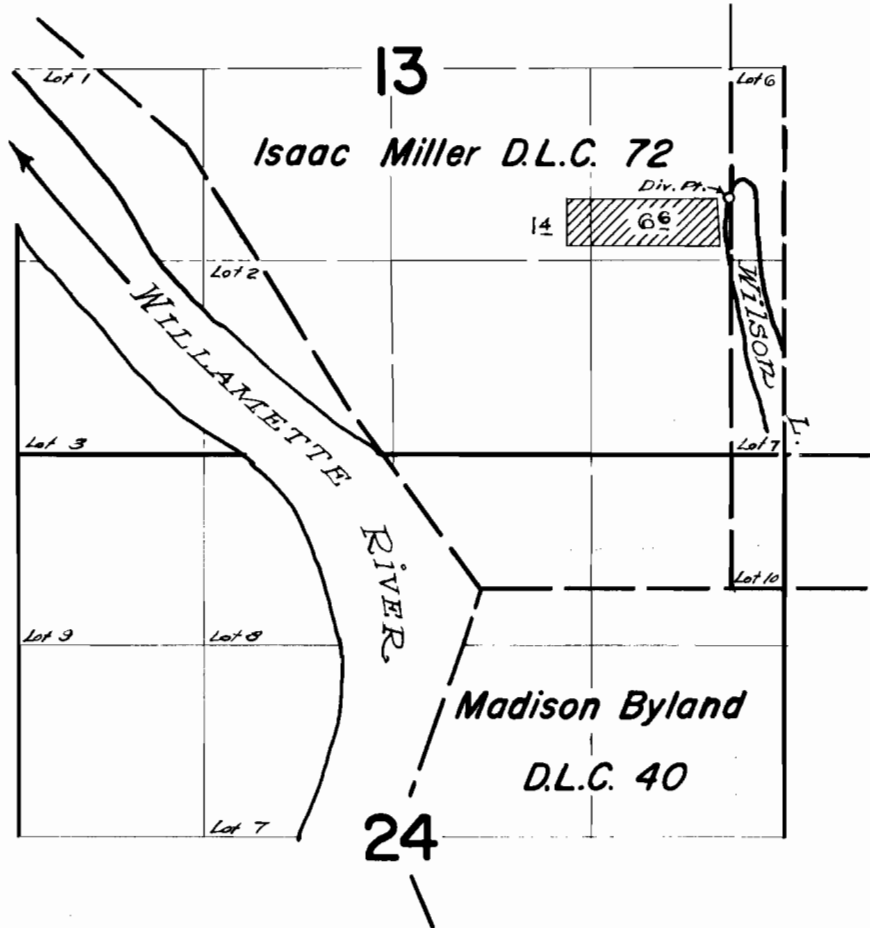

FINAL PROOF SURVEY
UNDER

Application No. **37529** Permit No. **27968**
IN NAME OF

WALTER C. & MARGARET DeSEMPLÉ

Surveyed *Sept. 4* 1963, by *C. Baker*