


T.13S.R.1W.W.M.

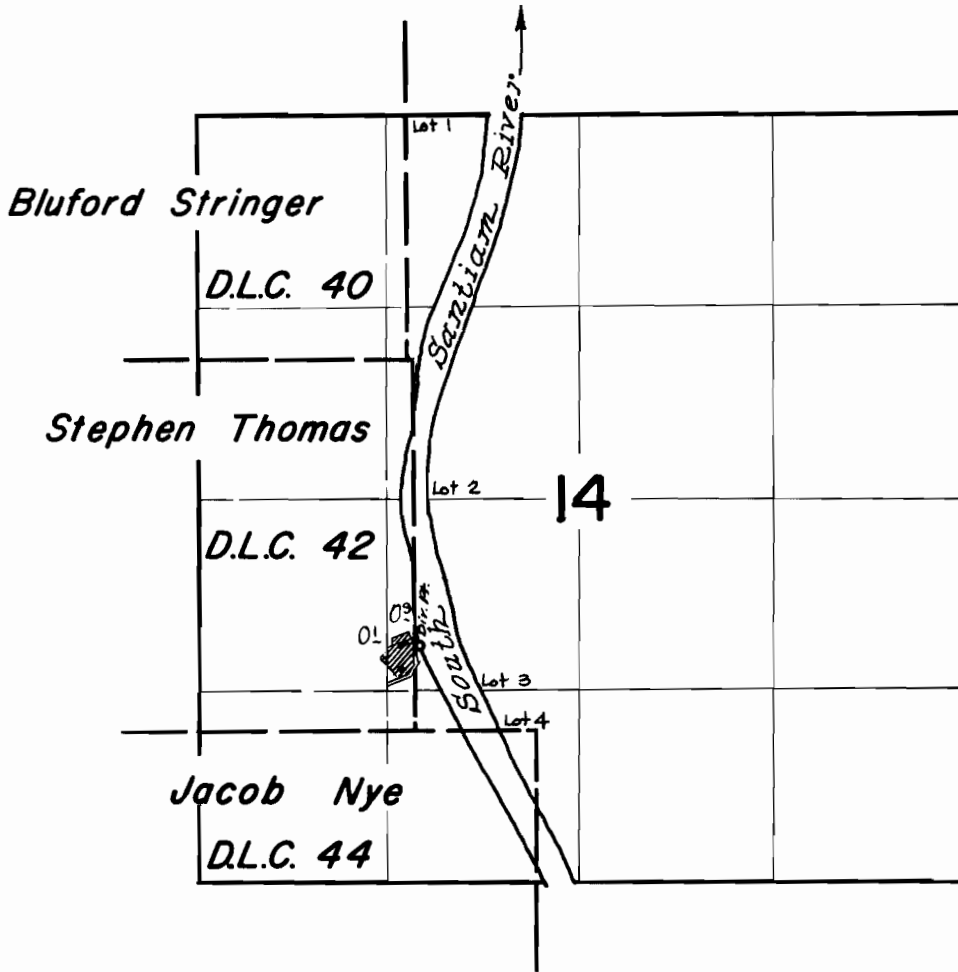

FINAL PROOF SURVEY
UNDER

Application No. **37871** Permit No. **28224**
IN NAME OF

JOHN G. & M. MARGARET BRUCE

Surveyed October 13 1964, by *[Signature]*