


T.13S.R.3W.W.M.

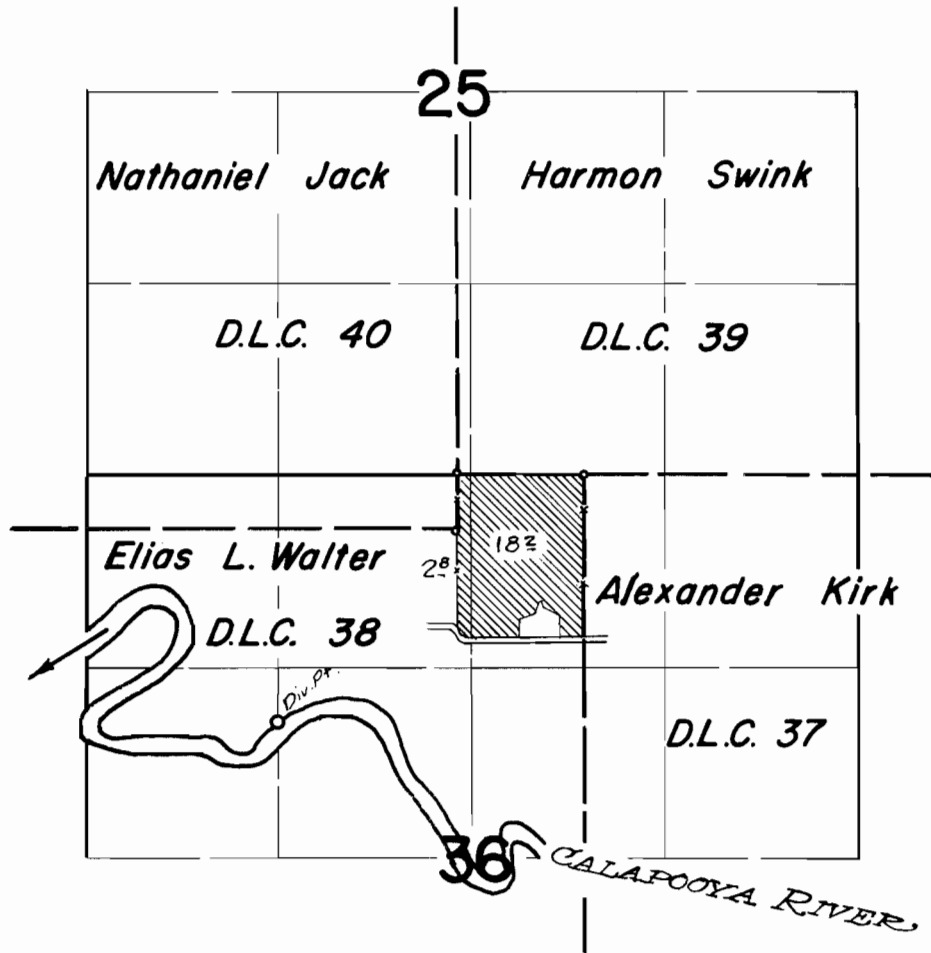

FINAL PROOF SURVEY
UNDER

Application No. 37872 Permit No. 28225
IN NAME OF

ROYAL L. & LOIS HENSHAW

Surveyed October 15 1964., by