


# T.14S.R.4W.W.M.

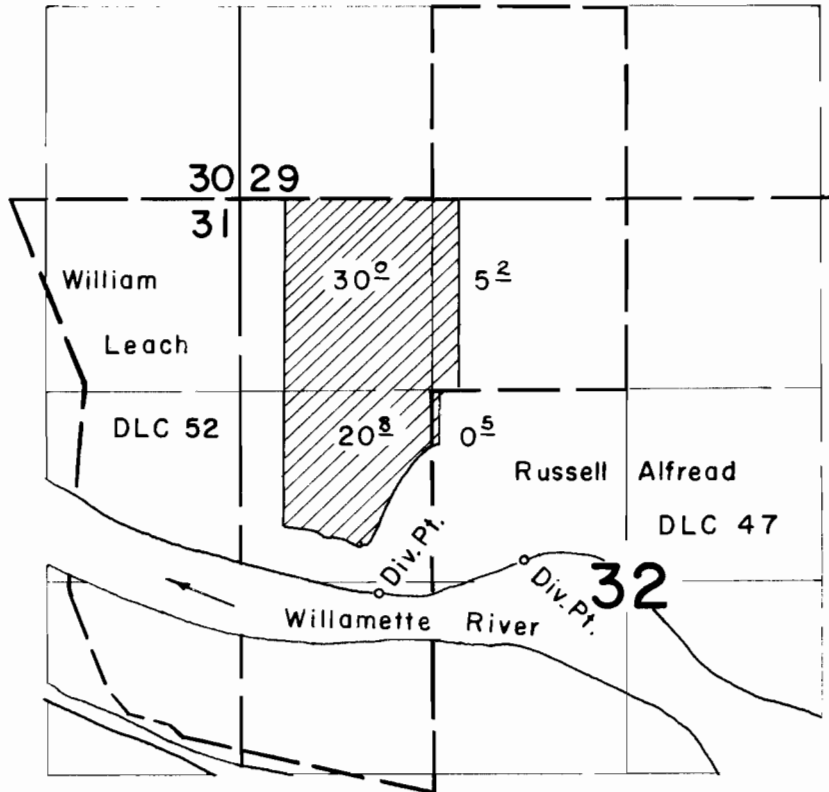

## FINAL PROOF SURVEY UNDER

Application No. 37696... Permit No. 28275...  
IN NAME OF

..... Carl & Alice Sandell .....

Surveyed May 28 1963, by Carl Baker.....