


T.10S.R.18&2 W.W.M.

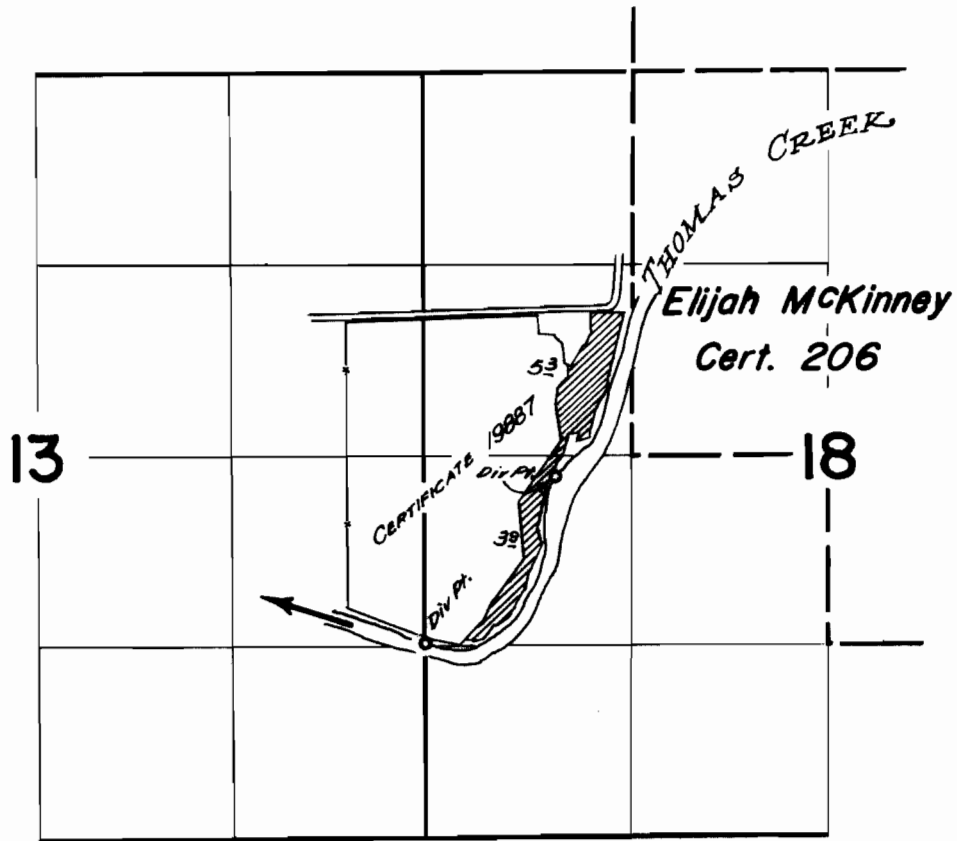

**FINAL PROOF SURVEY**  
UNDER

Application No. 38216.... Permit No. 28474....  
IN NAME OF

**FRED & EVELYN ROBINSON**

Surveyed April 27 1984., by *[Signature]*