


T. 8S. R. 2W.W.M.

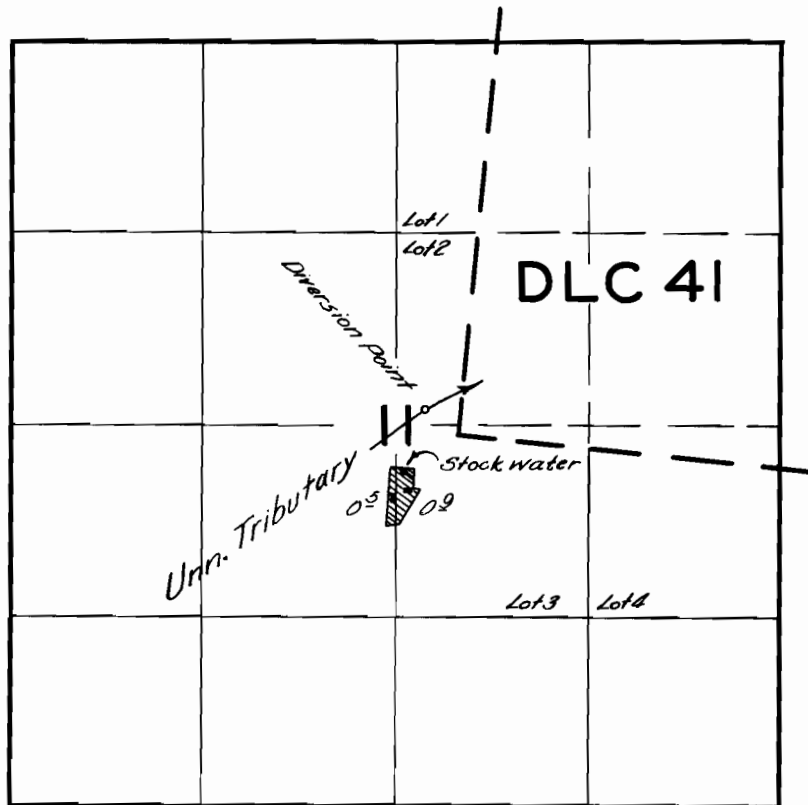

**FINAL PROOF SURVEY**  
UNDER

Application No. 37422 Permit No. 27868  
IN NAME OF

DAVID R. BROWN

Surveyed JULY 9 1965, by C. GARDNER