


# T.1S.R.4E.W.M.

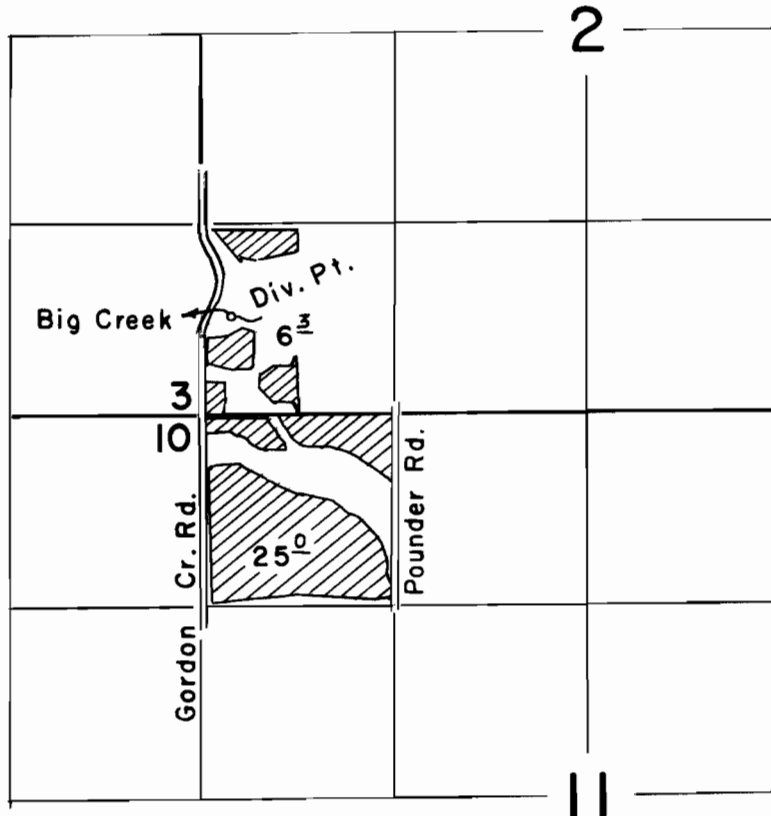

## FINAL PROOF SURVEY UNDER

Application No. 28605 Permit No. 22535  
IN NAME OF

Marsh F. Dunkin

Surveyed July 25 1963, by Tom Lauer