


T.1S.R.4E.W.M.

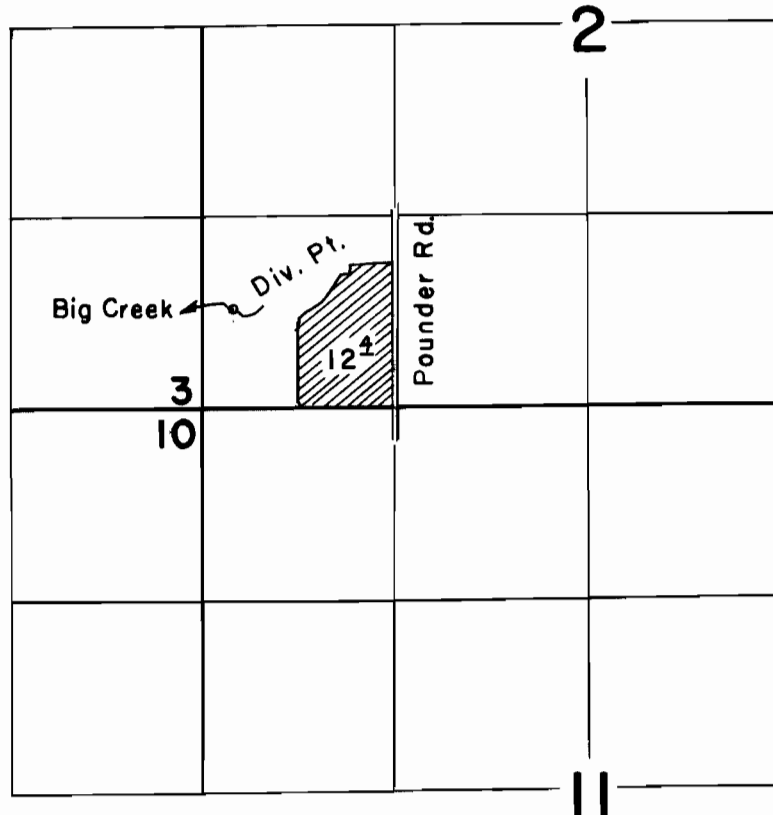

FINAL PROOF SURVEY UNDER

Application No. 30548... Permit No. 24053.
IN NAME OF

..... Marsh F. Dunkin

Surveyed July 25, 1963, by Tom Lauer.....