


# T.1N.R.3E.W.M.

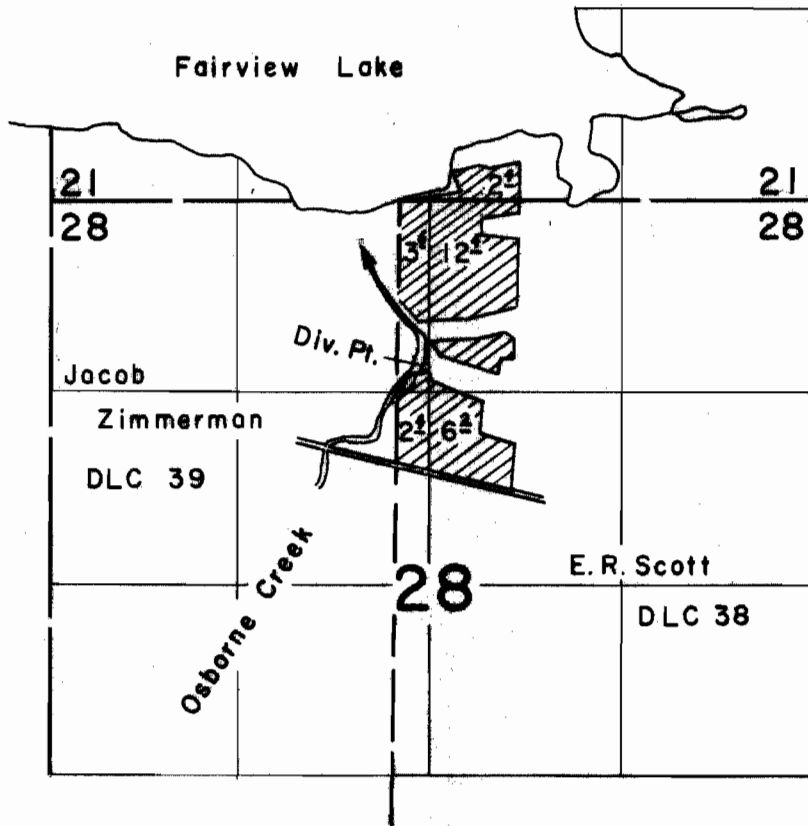

## FINAL PROOF SURVEY UNDER

Application No. 34536 Permit No. 27120  
IN NAME OF

Dr. Ralph W. Watters

Surveyed Aug 2, 1963, by Tom Lauer