


T.6S. R.5W. W.M.

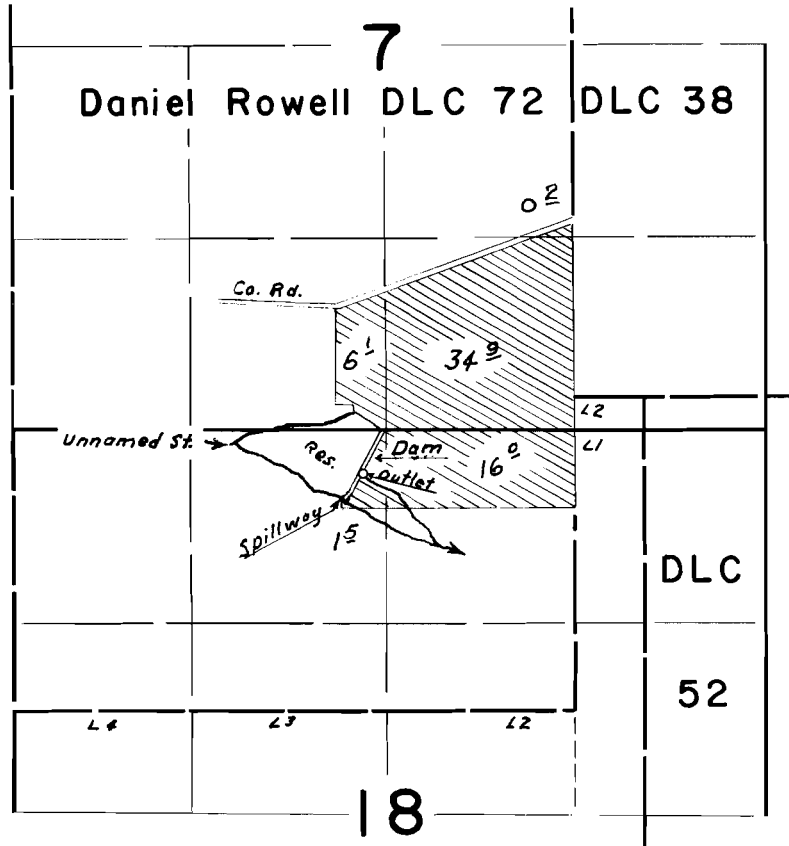

**FINAL PROOF SURVEY**  
UNDER

R-34344 R-2555  
Application No. 34345 Permit No. 27053  
IN NAME OF

**JACK & JAMES DE JONG**

Surveyed Sept. 24, 1964, by C.V. Gardner...