


T.6S. R.5W. W.M.

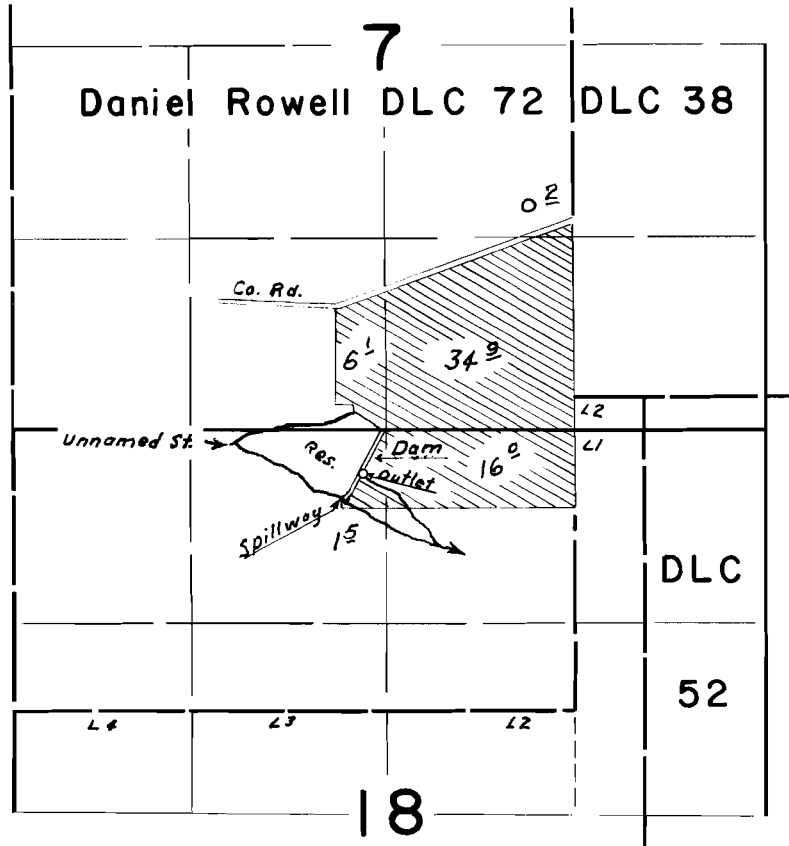

FINAL PROOF SURVEY
UNDER

R-34344 R-2555
Application No. 34345 Permit No. 27053
IN NAME OF

JACK & JAMES DE JONG

Surveyed Sept. 24, 1964, by C.V. Gardner...