


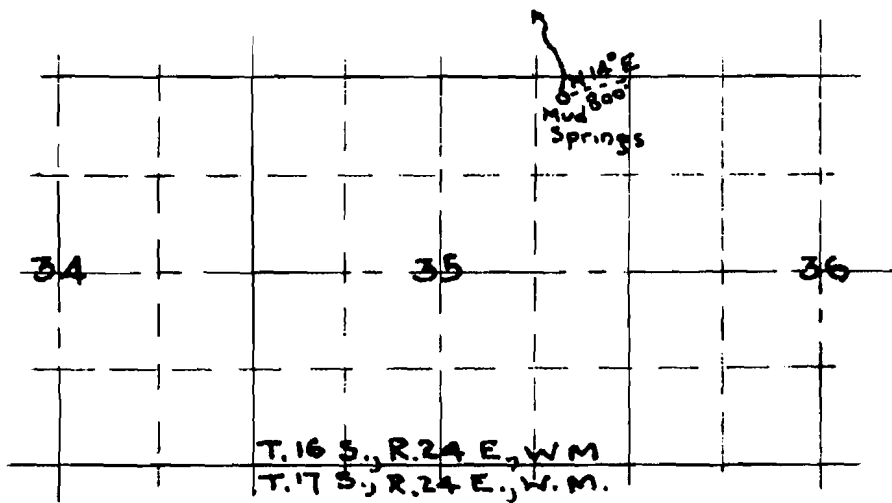

Map
of
Mud Springs.
Scale 2" = 1 mile

Application No. 6563
Permit No. 4114