


T.1&2S.R.7&8W.W.M.

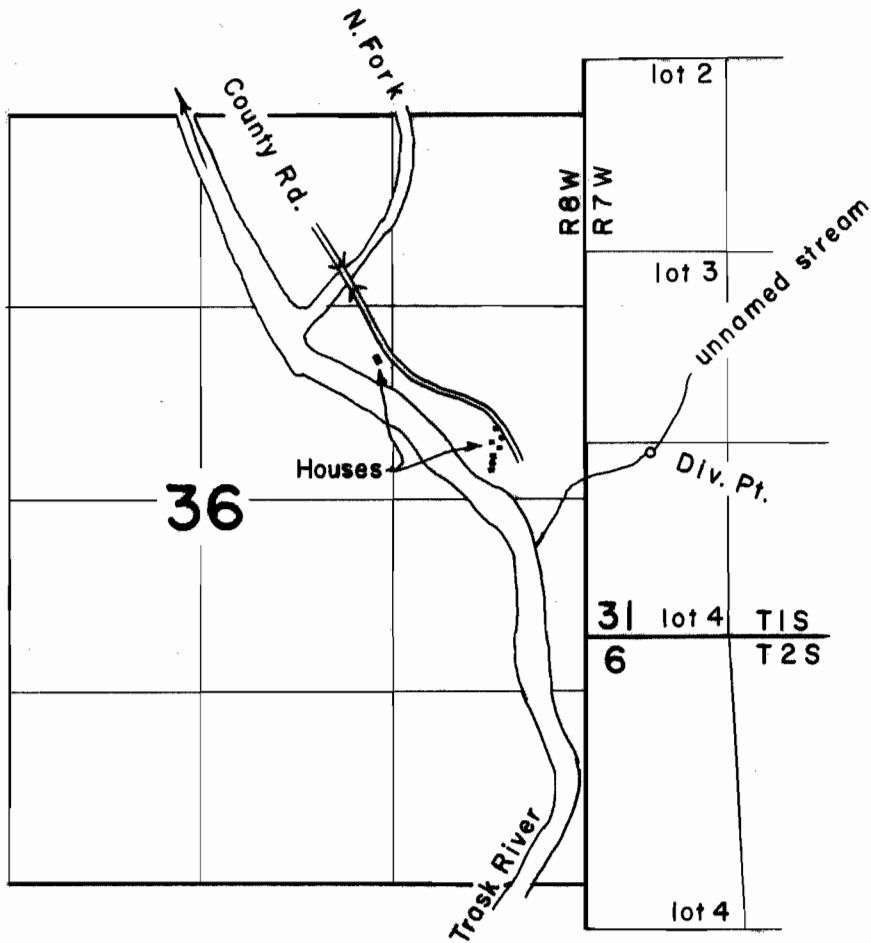

FINAL PROOF SURVEY
UNDER

Application No. 33227 Permit No. 26279
IN NAME OF

Nevan A. Helfrich

Surveyed July 29 1963, by Carl Baker

1963-X
LWG