


T. 1N. R. 39E. W. M.

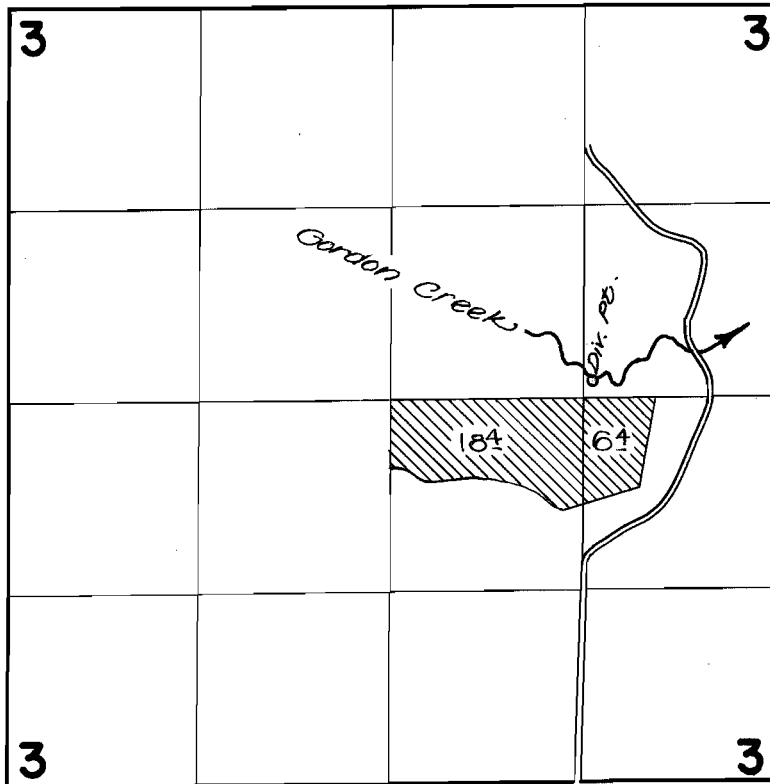

FINAL PROOF SURVEY UNDER

Application No. **30836** Permit No. **24271**
IN NAME OF

JIM MORGAN

Surveyed *Sept. 24 1963* by *T. Lauer*

PL