


T.1S.R.38E.W.M.

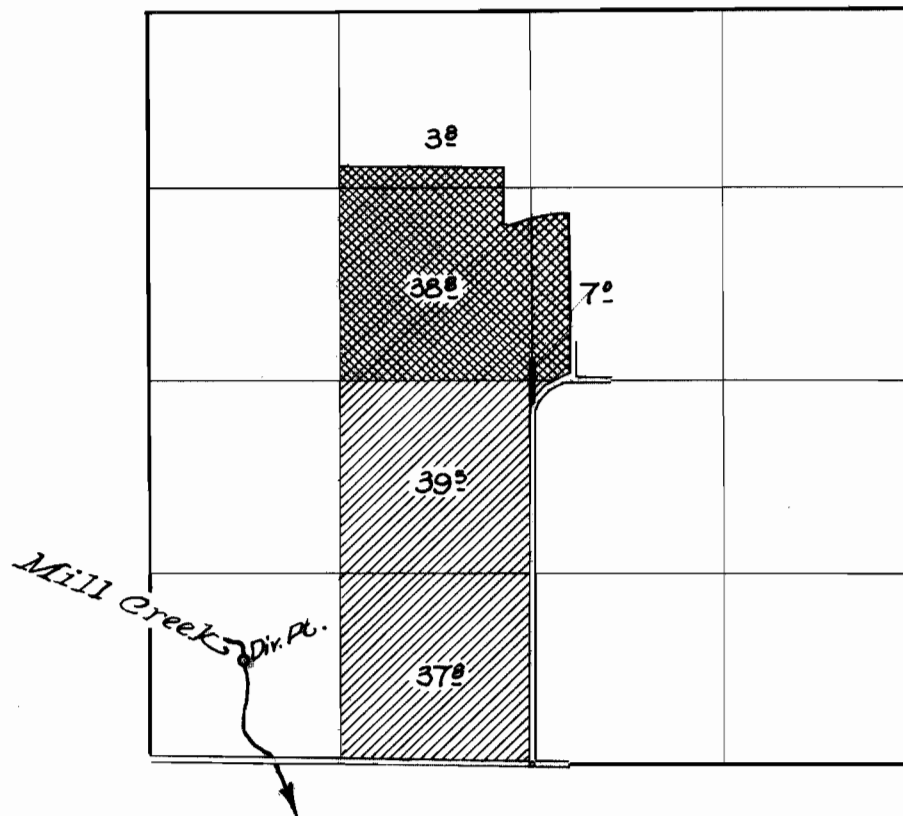

FINAL PROOF SURVEY
UNDER

Application No. **37236** Permit No. **27751**
38510 **28666**
IN NAME OF

LAWRENCE R. & ELEANOR E. STARR

Surveyed Oct. 1, 1963, by T. Lauer