


Basin 4 Dist 3

28353

T.I.N.R.I.I.E.W.M.

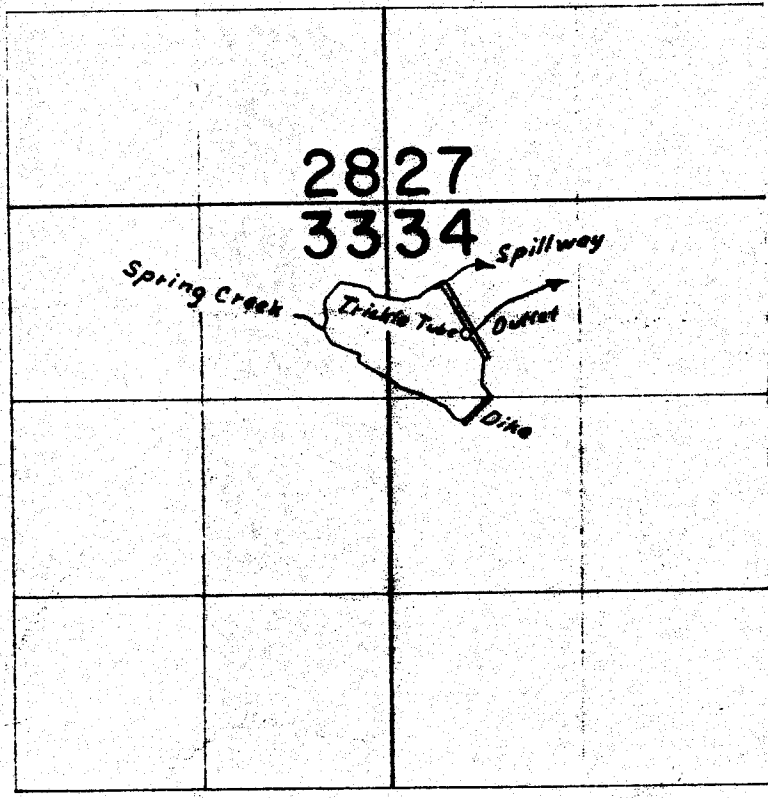

FINAL PROOF SURVEY
UNDER

38201 28353
Application No. R-36798 Permit No. R-3131
IN NAME OF

WILLIAM D. KETCHUM

Surveyed Oct. 22, 1965, by *C. J. Gardner*