


T. 2 S. R. 1 W. W. M.

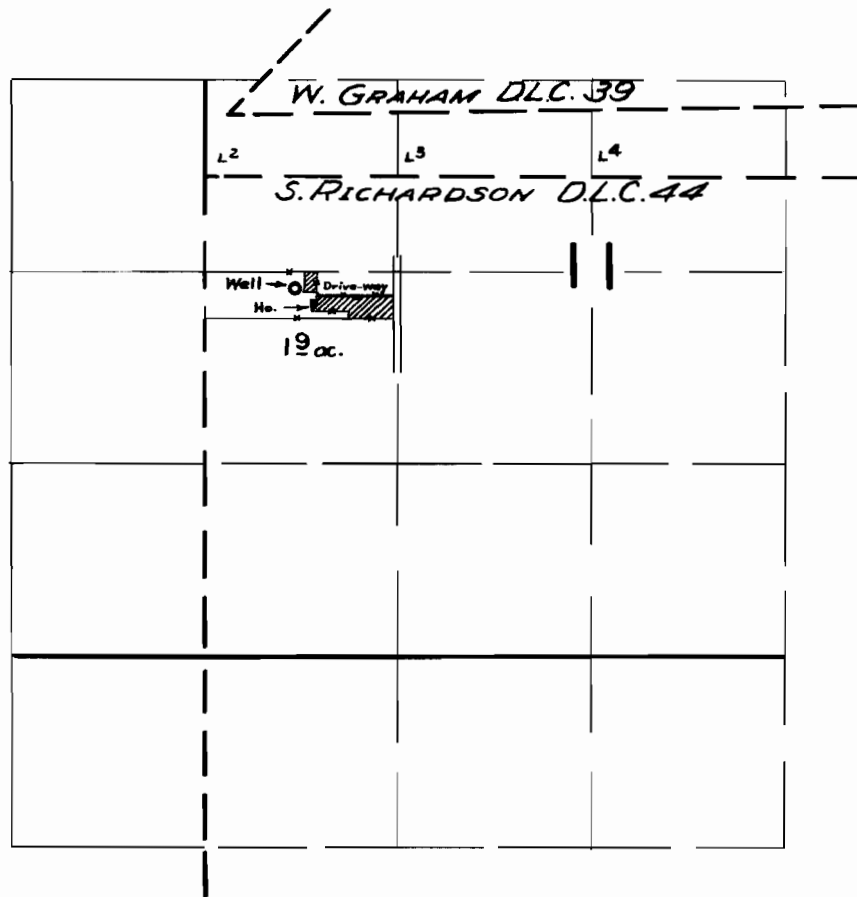

**FINAL PROOF SURVEY**  
UNDER

Application No. G-1734 Permit No. G-1612  
IN NAME OF

MRS. MYRON P. DRESSLER

Surveyed April 1, 1963, by m. Bish