


# T.I.S.R.4 W.W.M.

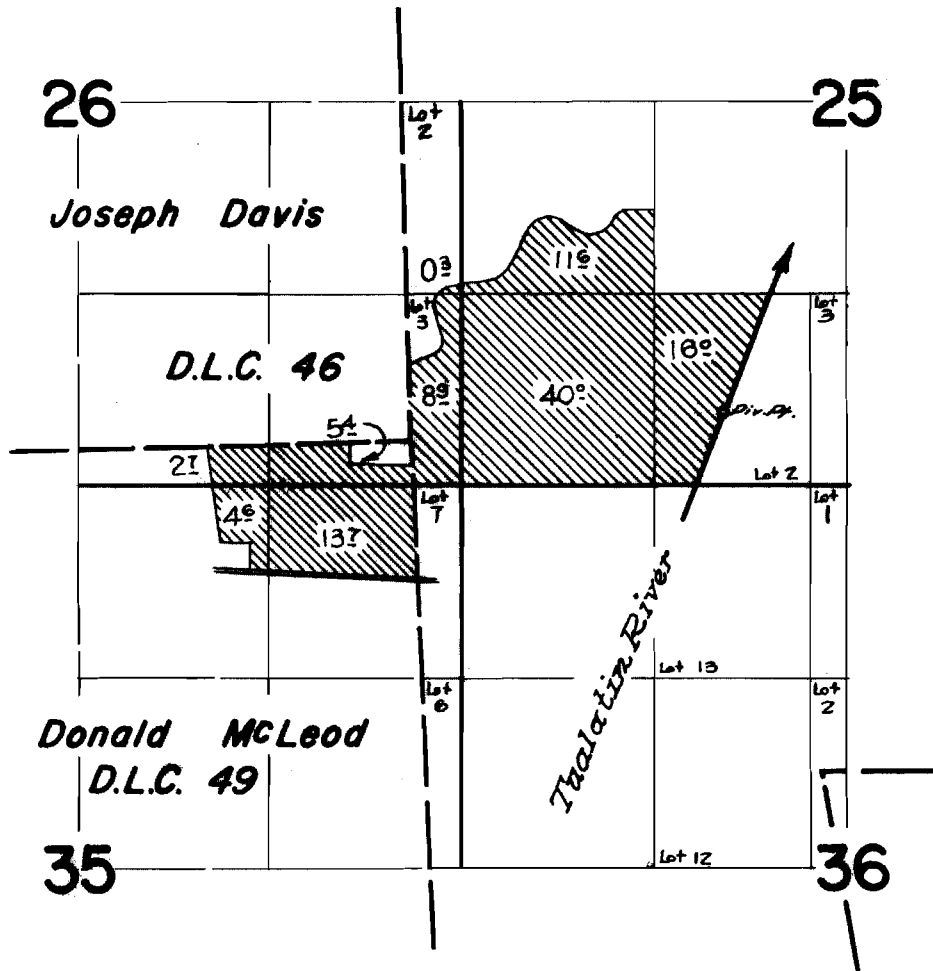

## FINAL PROOF SURVEY UNDER

Application No. 34611 Permit No. 27177  
IN NAME OF

HAROLD J. BATES

Surveyed May 2 1962  
Jan 5 1963, by C. Baker