


7.9 S. R. 2 W. W.M.

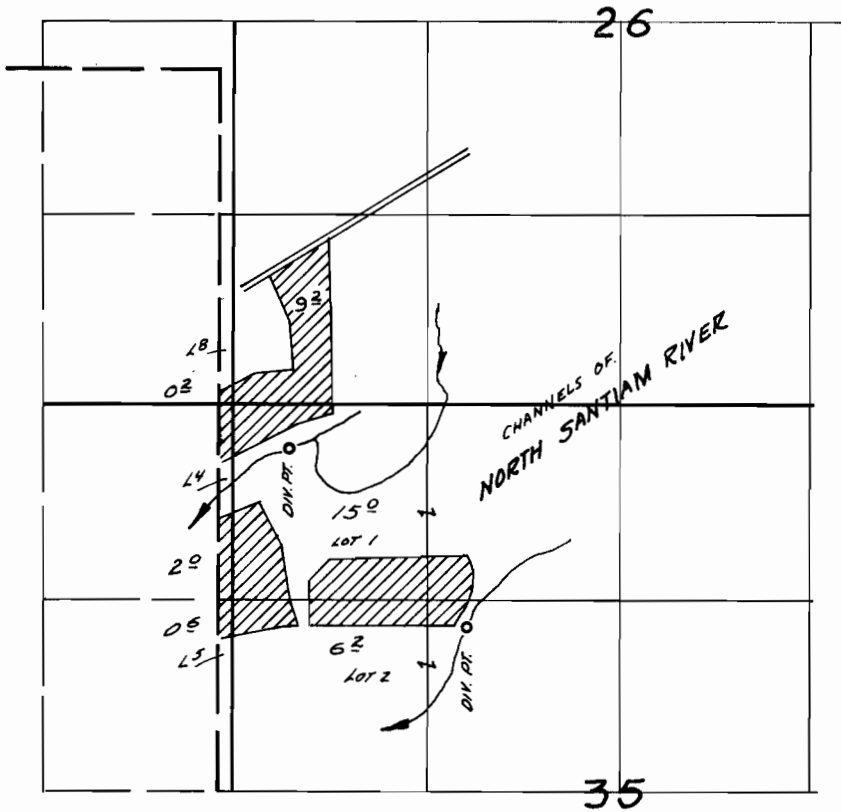

Tracing of a survey made April 7, 1954 by T. Jones on photo DFN-20-52  
the original map apparently has been lost  
Yes. Garner 12-8-68

FINAL PROOF SURVEY  
UNDER

Application No 22141 Permit No. 17435  
IN Name of

W. V. CHAMBERLIN