


T. 14S. R. 45E.W.M.

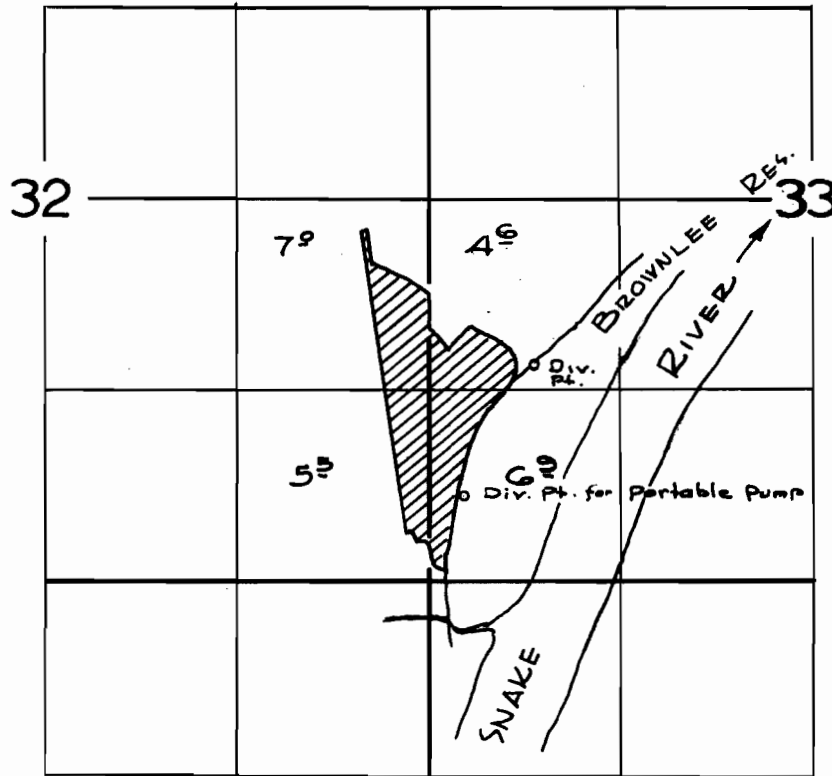

FINAL PROOF SURVEY
UNDER

Application No. 33010 Permit No. 26100
IN NAME OF

OREGON STATE HIGHWAY COMMISSION

Surveyed Mar. 16, 1964 by D.B. Hall

RECEIVED

STATE ENGINEER