


T.15 S.R. 4 & 5 W.W.M.

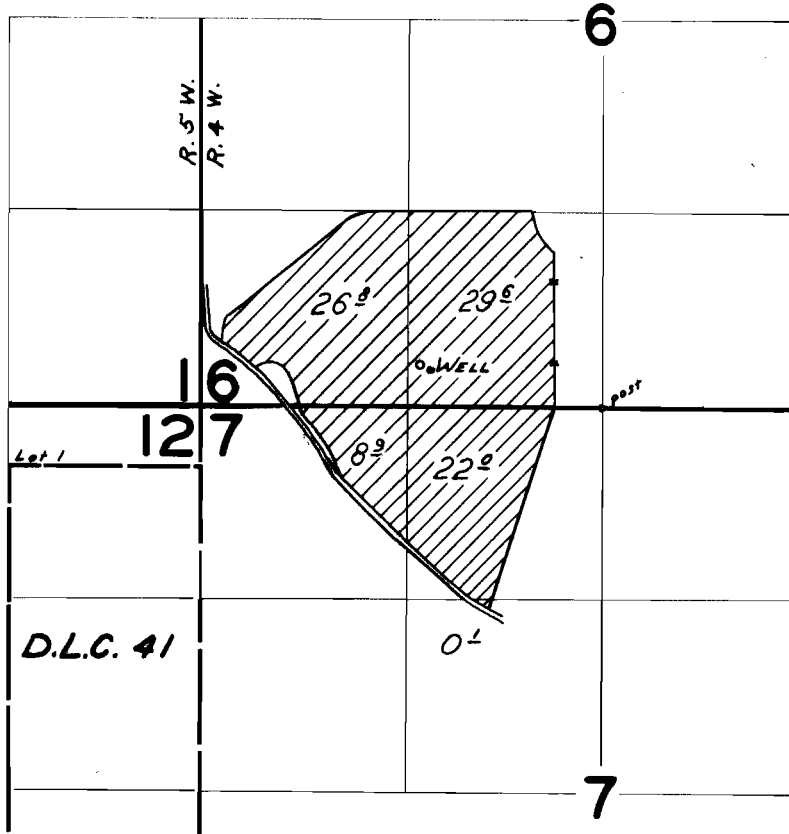

FINAL PROOF SURVEY
UNDER

Application No. G-2196 Permit No. G-2032
IN NAME OF

EARL C. AND RAYMOND JAGER

Surveyed APR. 29 1963, by C. BAKER