


T.14S.R.4&5W.W.M.

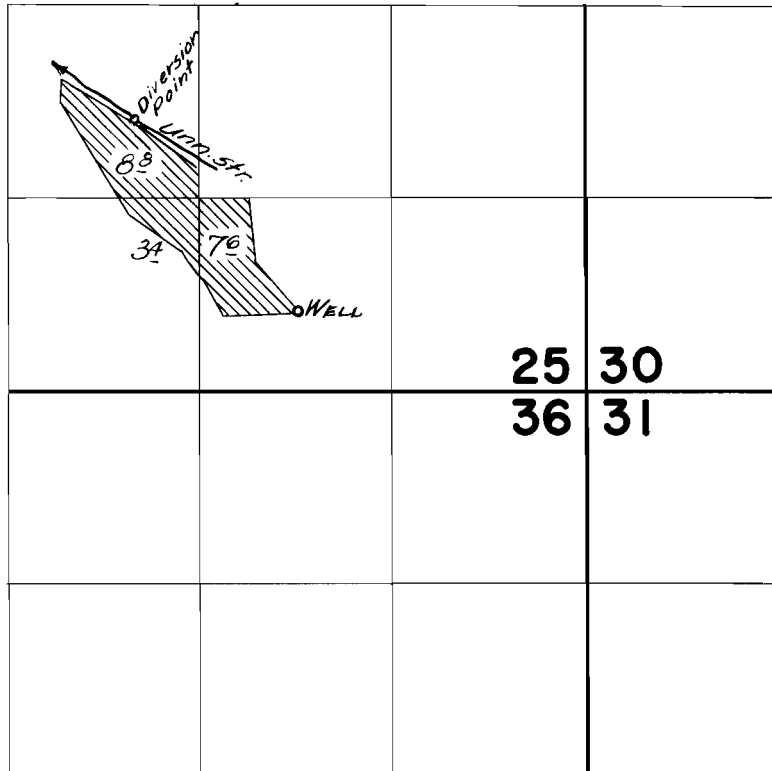

FINAL PROOF SURVEY UNDER

Application No. **32448** Permit No. **25625**
IN NAME OF

CHESTER CROWSON

Surveyed *May 3 1963*, by *C. Baker*