


T.14S.R.7&8W.W.M.

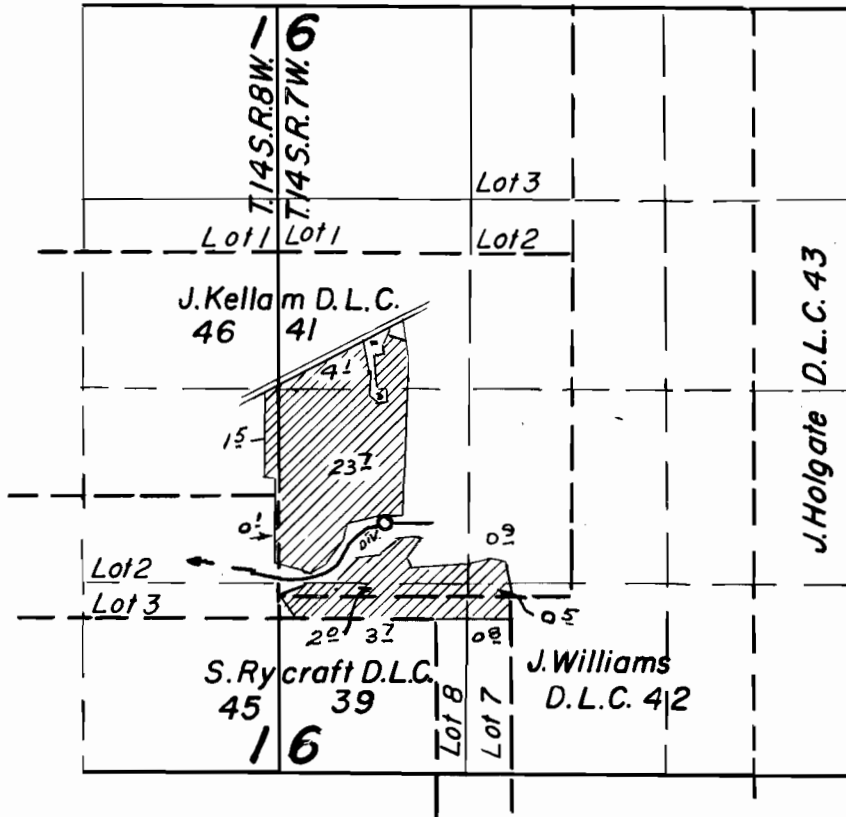

FINAL PROOF SURVEY UNDER

Application No. 34448 Permit No. 27063
IN NAME OF

Mrs. ANN MAERKS

Surveyed March 9, 1965, by *Floyd L. Siegmund*