


T.3S.R.1W.W.M.

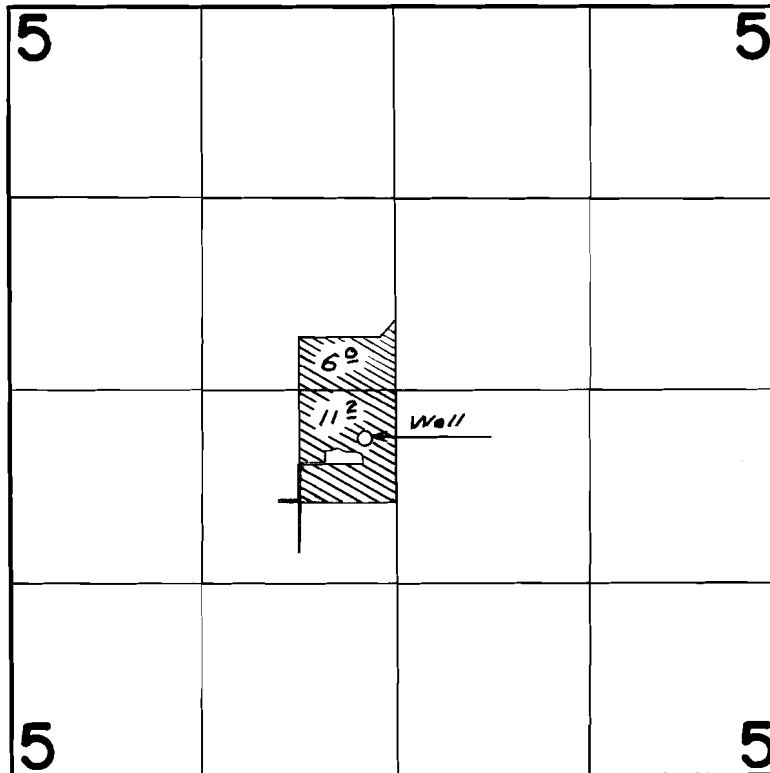

FINAL PROOF SURVEY
UNDER

Application No. G-2011 Permit No. G-1847
IN NAME OF

GLENN E. HOLST

Surveyed August 28, 1964, by C.J. Gardner