


T.2S. R.2E. W.M.

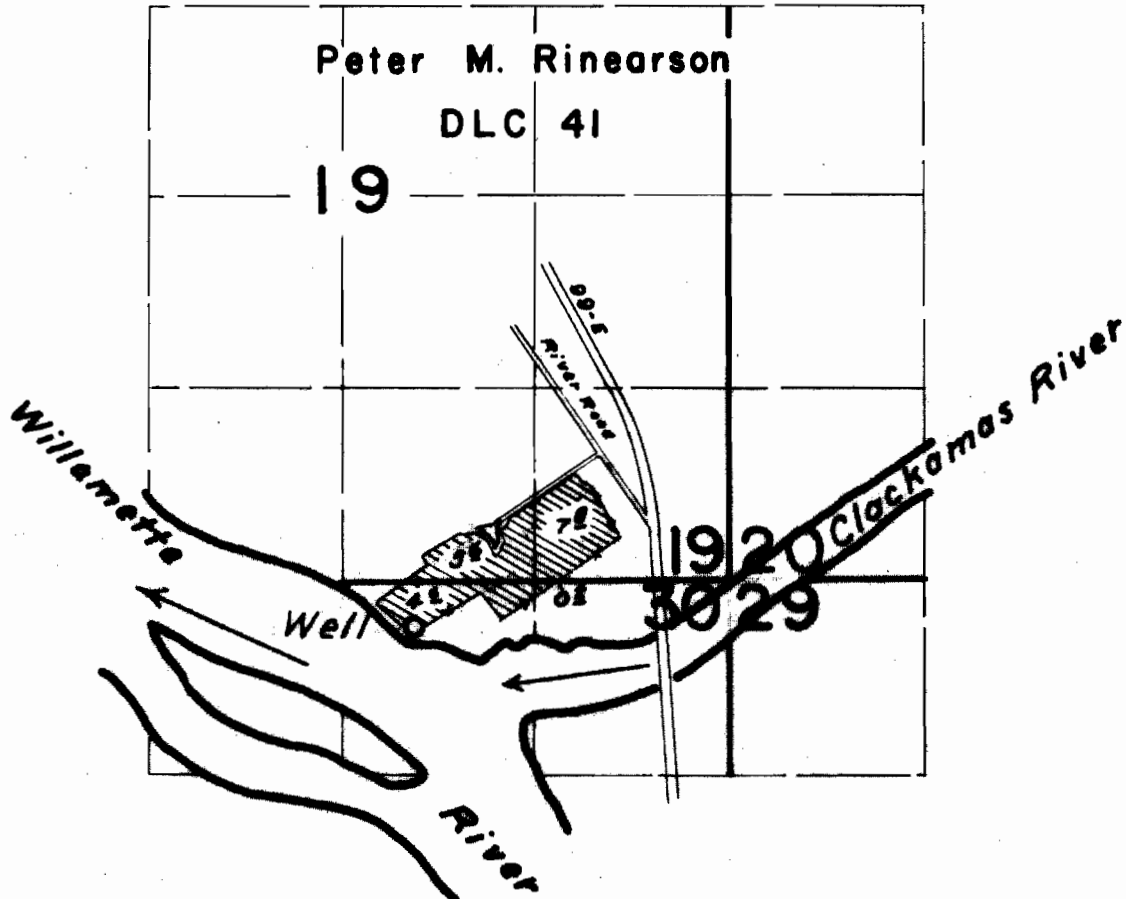

**FINAL PROOF SURVEY**  
UNDER

Application No. G-2024. Permit No. G-1862.  
IN NAME OF

**CHARLES F. THOMAS**

Surveyed August 11, 1964, by *C.J. Gardner*