


# T.4S. R.1E.W.M.

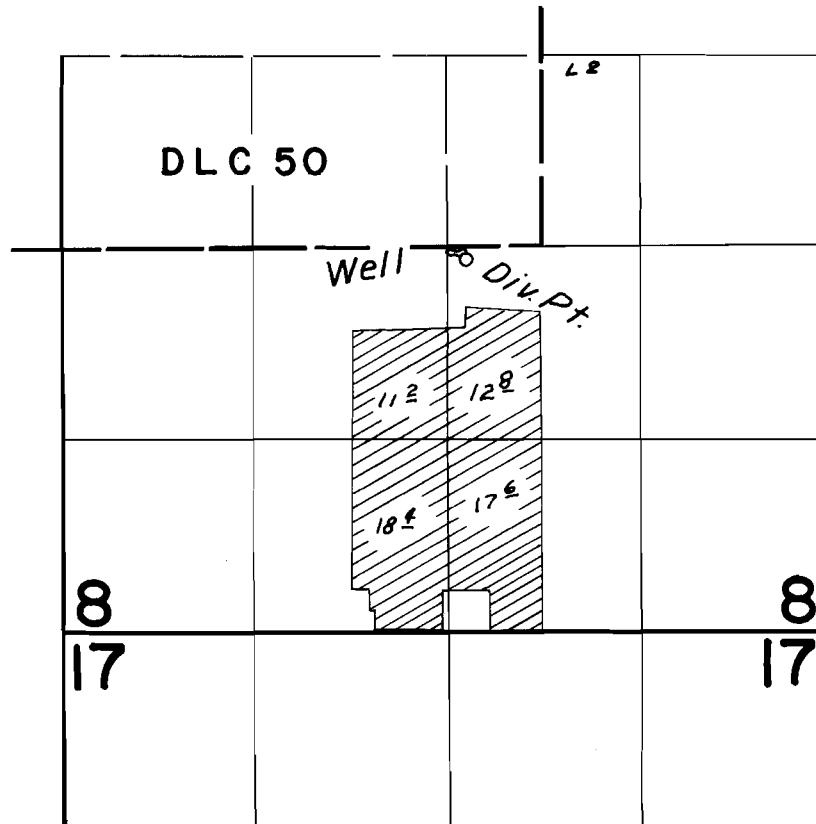

## FINAL PROOF SURVEY UNDER

Application No. G-2065 Permit No. G-1903  
IN NAME OF

P. C. McCORMICK

Surveyed Sept. 2, 1964, by C. J. Gardner.