


T.4S. R.1E. W.M.

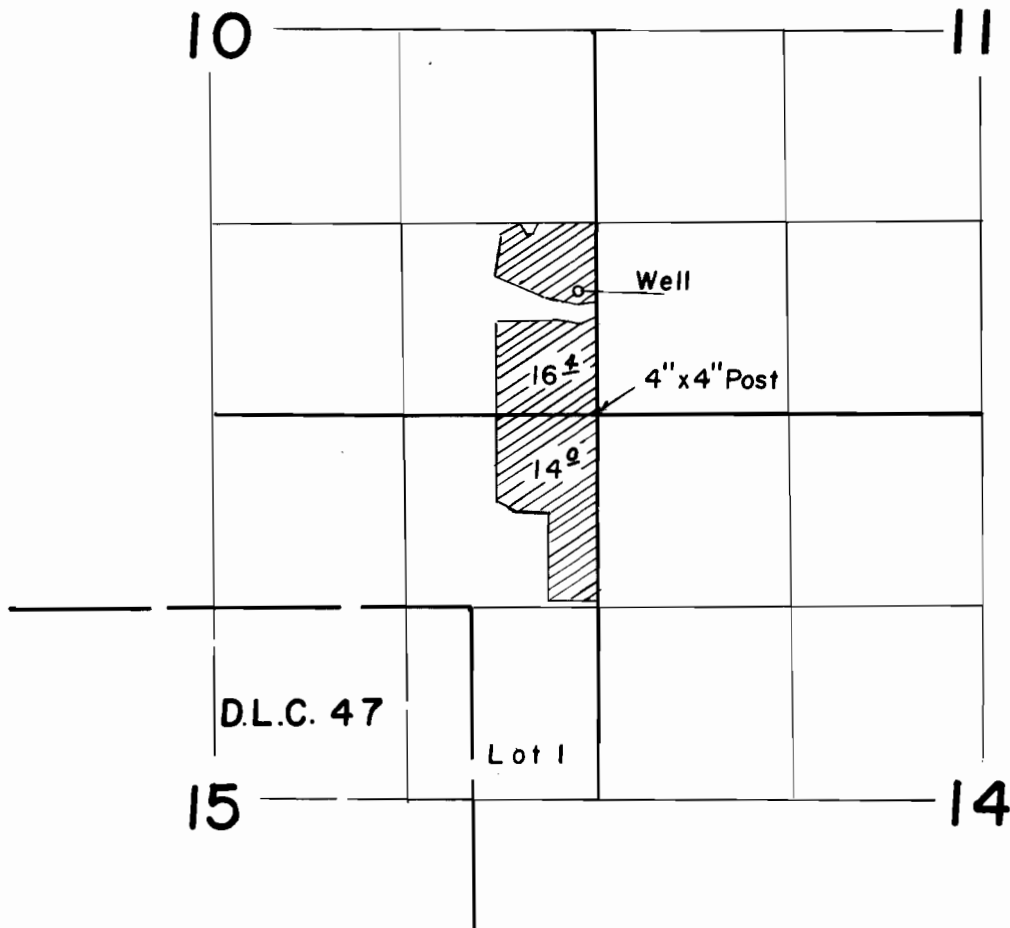

FINAL PROOF SURVEY
UNDER

Application No. G-2362 Permit No. G-2178
IN NAME OF

Glenn Herman

Surveyed Sept. 1, 1964, by C.J. Gardner