


T.5S. R.1E. W.M.

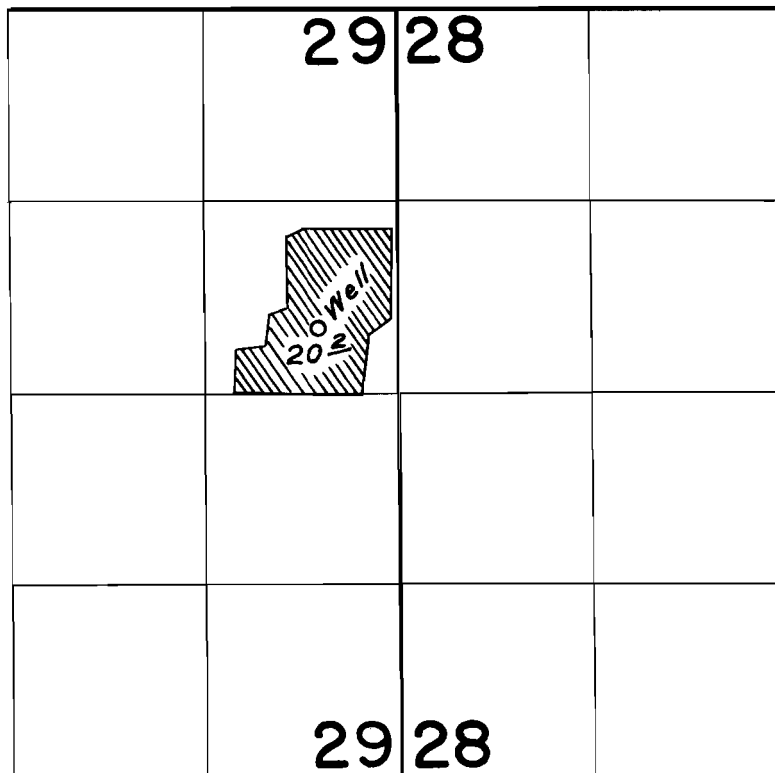

FINAL PROOF SURVEY
UNDER

Application No. G-2620 Permit No. G-2430
IN NAME OF

NORBERT KIMLINGER

Surveyed July 20, 1964, by C.J. Gardner